


T. 34 S., R. 3 W., W. M.

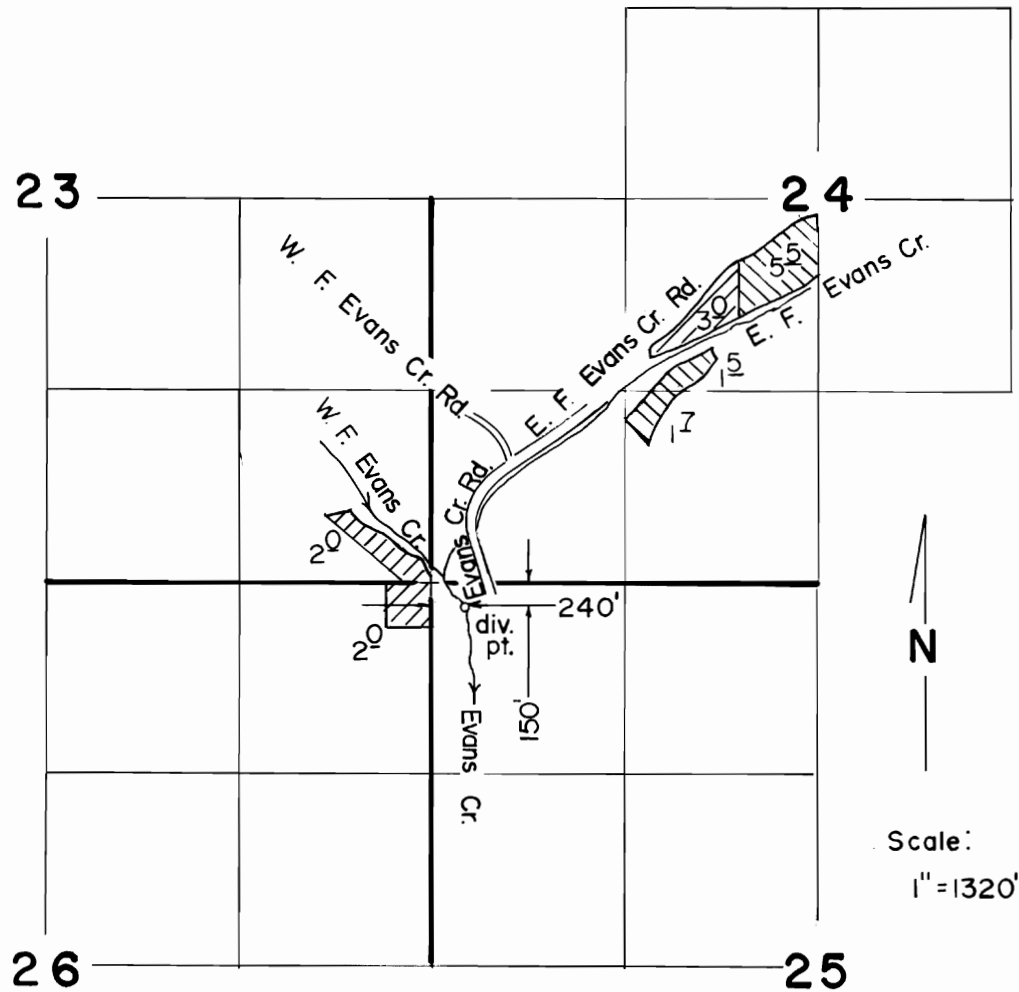

Primary



Supplemental



FINAL PROOF SURVEY UNDER

TRANSFERS NO. 5139, 5140, 5141, 5142

Application No. Permit No.

IN NAME OF

ROBERT M. STOREY

Surveyed JUN....3... 1987, by B....S....JAMES...