


FINAL PROOF SURVEY MAP

IN THE NAME OF SCOTT R. AND EDITH P. VIERCK

APPLICATION S-73933
R-73934

PERMIT 52496
R-11815

SECTION 17, TOWNSHIP 29 SOUTH, RANGE 14 WEST, W.M.

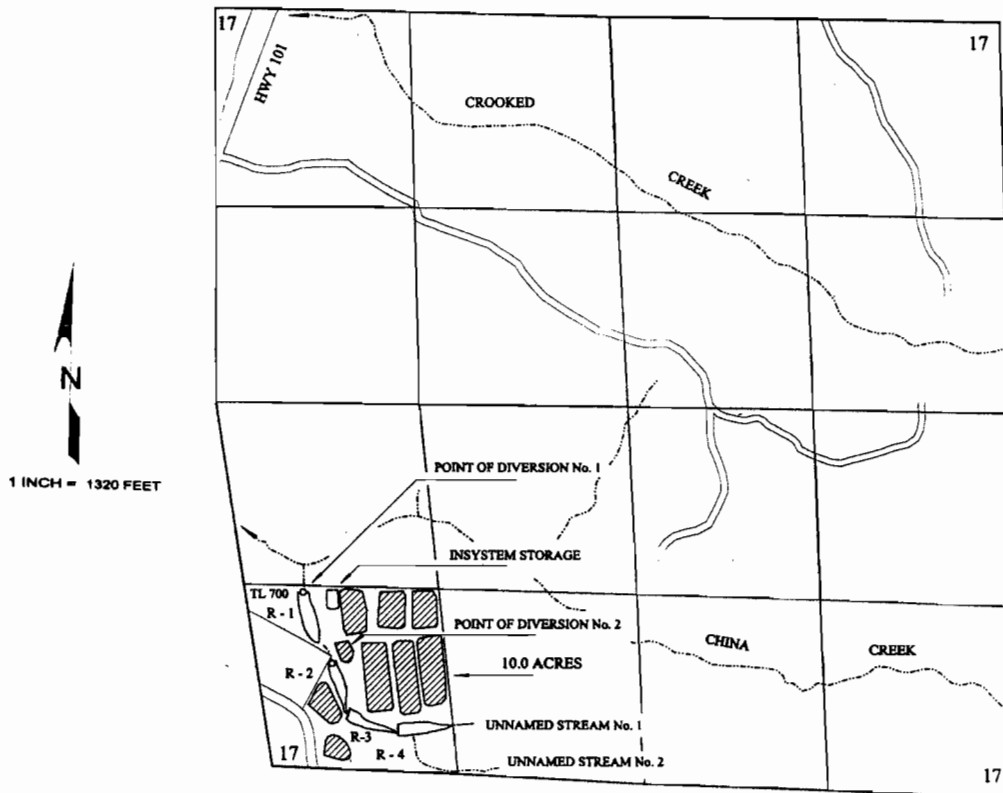

THE POINTS OF DIVERSION AND RESERVOIRS ARE LOCATED AS FOLLOWS:

RESERVOIR No.	NORTH	EAST	¼ ¼ SECTION	SECTION
RESERVOIR No. 1	1200 FEET	215 FEET	SW¼ SW¼	17
RESERVOIR No. 2	710 FEET	420 FEET	SW¼ SW¼	17
RESERVOIR No. 3	360 FEET	530 FEET	SW¼ SW¼	17
RESERVOIR No. 4	240 FEET	870 FEET	SW¼ SW¼	17

ALL FROM THE SOUTHWEST CORNER OF SECTION 17 AND WITHIN SECTION 17, TOWNSHIP 29 SOUTH, RANGE 14 WEST, W.M.; COOS COUNTY.

RECEIVED

SEP 27 1987

WATER RESOURCES DEPT.
SALEM, OREGON



THE PURPOSE OF THIS MAP IS TO IDENTIFY THE LOCATION OF THE WATER RIGHT. IT IS NOT INTENDED TO PROVIDE INFORMATION RELATIVE TO THE LOCATION OF PROPERTY OWNERSHIP BOUNDARY LINES.