


T.6N. R.35E.W.M.

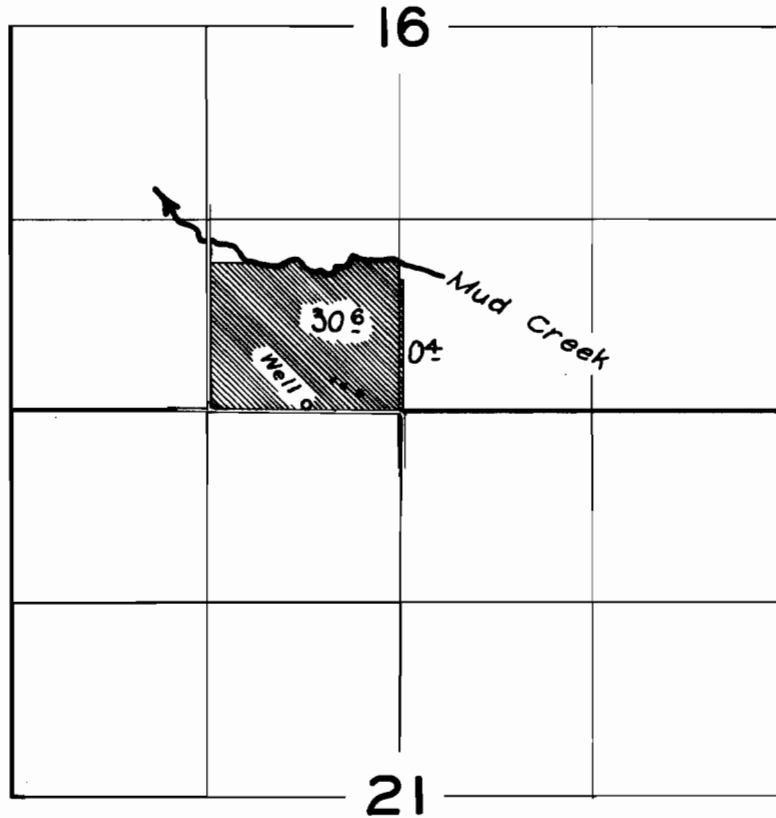

**FINAL PROOF SURVEY**  
UNDER

Application No. G-847. Permit No. G-762.  
IN NAME OF

*WILLIE RAND*

Surveyed 13 Nov. 1958, by C.O. Bartels...