


# FINAL PROOF WATER RIGHTS MAP

UNDER  
PERMIT 52336  
APPLICATION 72629

MAP NO. 19-12-14-4-2, TL 1400  
NW 1/4 SE 1/4, SEC 14, T19S, R12W, W.M.  
LANE COUNTY, OREGON

FOR: JAMES K. RASH  
1315 CORUM AVE.  
EUGENE, OREGON 97401

PREPARED BY: WOBBE & ASSOCIATES, INC.  
510 KINGWOOD ST. / P.O. BOX 3093  
FLORENCE, OR 97439  
DATE: AUGUST 18, 2000

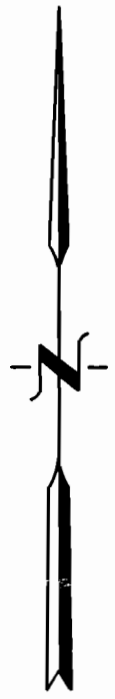

1" = 400'

