

14

RECEIVED

JAN 22 1997

WATER RESOURCES DEPT.
SALEM, OREGON

NW 1/4 SE 1/4

NE 1/4 SE 1/4

SW 1/4 SE 1/4

SE 1/4 SE 1/4

WOAHINK

POINT OF DIVERSION
N 54° 00' W 667'
FROM THE SE COR.
OF SEC. 14, T19S,
R12W, W.M.

PUMP HOUSE

HOUSE

LAKE

F92-30

14 13
23 24


FINAL PROOF

WATER RIGHTS MAP
UNDER PERMIT 52333


SE 1/4 SE 1/4, SEC. 14, T19S, R12W, W.M.
DUNES CITY, LANE COUNTY, OREGON
19-12-14-4-4, T.L. 700

FOR: EMMETT DEVEREUX
P.O. BOX 1607
FLORENCE, OR 97439

PREPARED BY: WOBBE & ASSOCIATES, INC.
510 KINGWOOD ST./P.O. BOX 1136
FLORENCE, OR 97439
DECEMBER 10, 1996

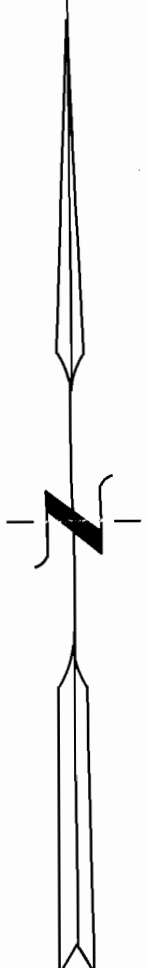

SCALE
1" = 400'

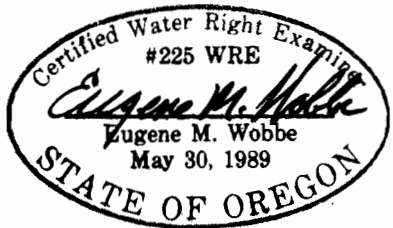

THIS MAP IS FOR THE PURPOSE OF IDENTIFYING THE LOCATION OF THE WATER RIGHTS ONLY. THERE IS NO INTENT TO PROVIDE DIMENSIONS OR LOCATION OF PROPERTY OWNERSHIP LINES.