


AUG 14 1998

WATER RESOURCES DEPT.
SALEM, OREGON

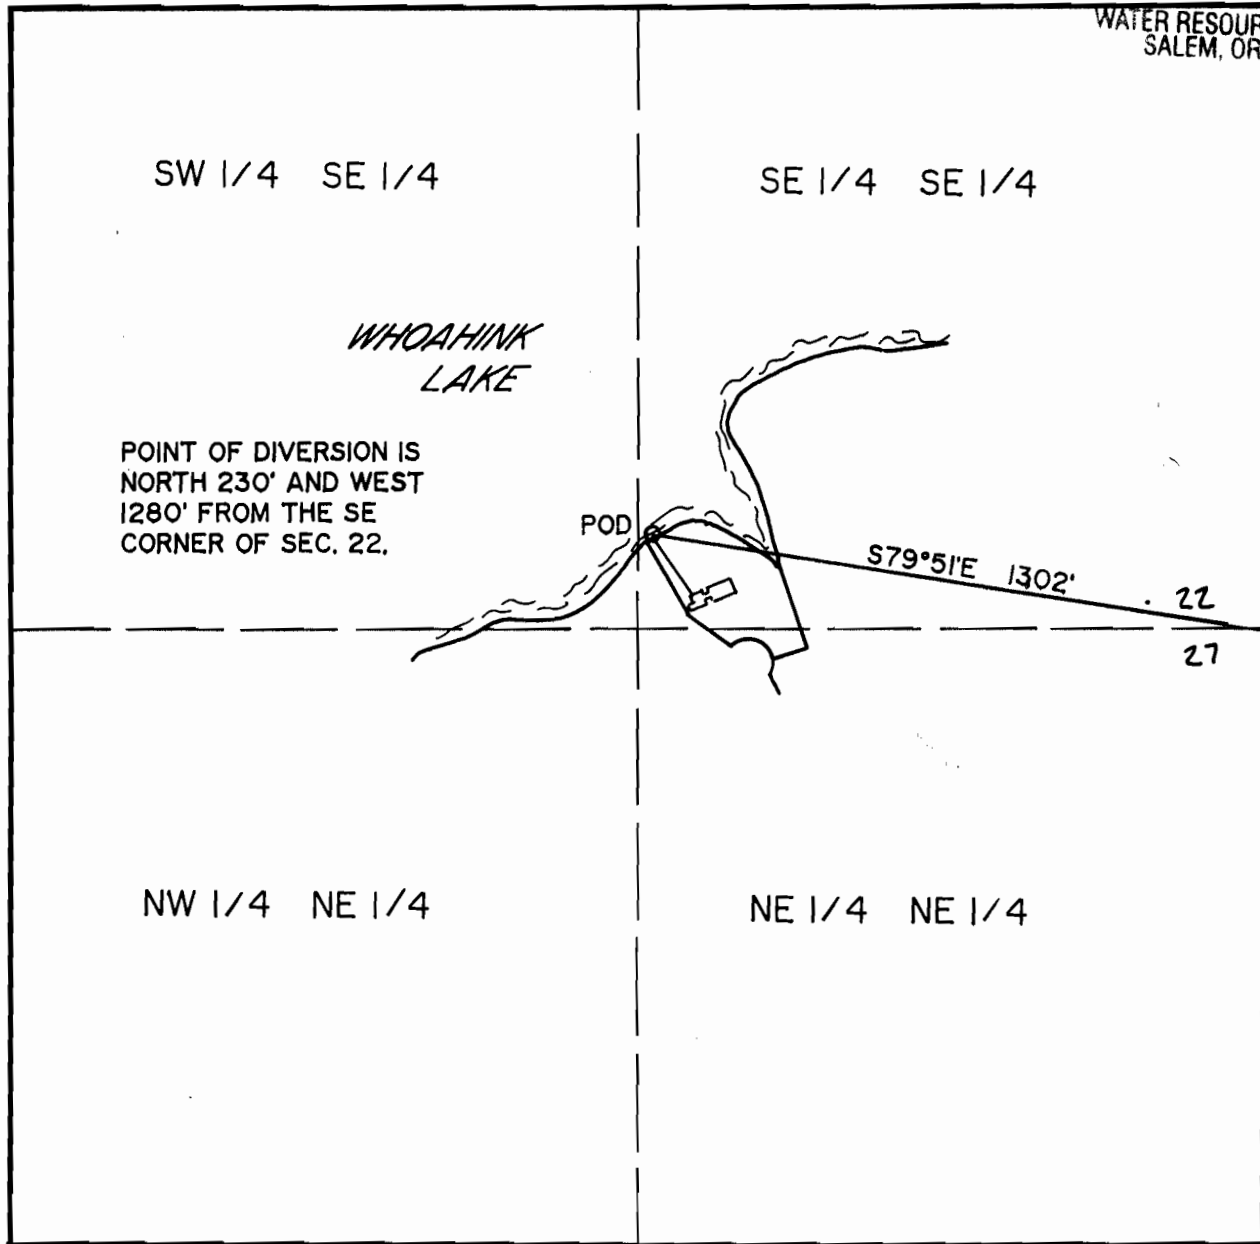

FINAL PROOF WATER RIGHTS MAP

UNDER

PERMIT NO. 52819
APPLICATION NO. 80919

SE 1/4, SEC 22, T19S, R12W, W.M.
DUNES CITY, LANE COUNTY, OREGON
19-12-22-4, TL 800

FOR: RICHARD L. SPRAGUE
AND MARY JAYNE SPRAGUE
04949 BRENTWOOD COURT
FLORENCE, OREGON 97439

PREPARED BY: WOBBE & ASSOCIATES, INC.
510 KINGWOOD ST. / P.O. BOX 3093
FLORENCE, OR 97439
DATE: JULY 6, 1998

THIS MAP IS FOR THE PURPOSE
OF IDENTIFYING THE LOCATION
OF THE WATER RIGHT ONLY.
THERE IS NO INTENT TO PROVIDE
DIMENSIONS OR LOCATION OF
PROPERTY OWNERSHIP LINES.



SCALE
1"=400'

