


Section 28 Township 23S Range 12W W.M.  
Coos County

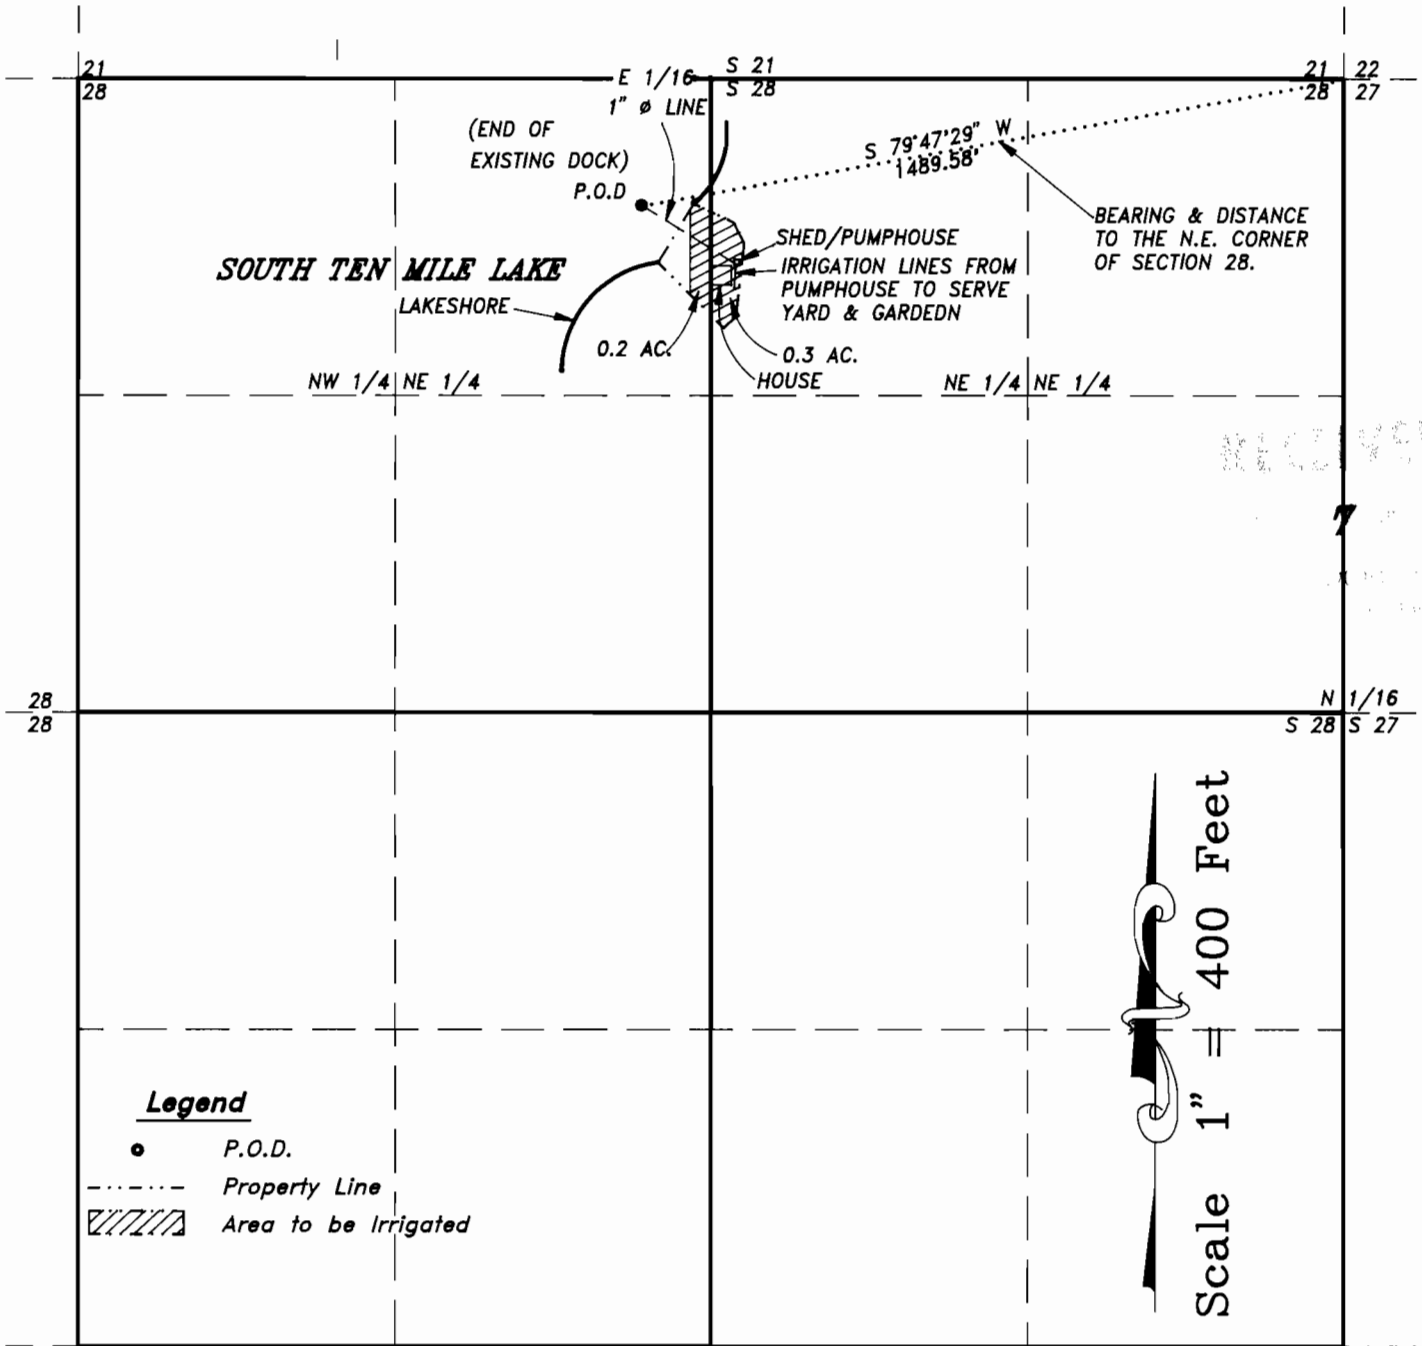

**EXAMINERS DISCLAIMER STATEMENT**

The preparation of this map was for the purpose of identifying the location of the Water Right only and has no intent to provide dimensions or location of property ownership lines.

**FINAL PROOF SURVEY**

Application # 70009 Permit # 50734

IN THE NAME OF

Lambert S. and Betty J. Whitcomb



Surveyed on January 28, 1993 by R.E. Stuntzner