


# FINAL PROOF SURVEY

IN THE NAME OF  
RUTH E. HARPOLE

SURVEYED ON 9/4/2000 BY J.L.ESTABROOK

TAX LOT NO. TL1400 23 12 21DD  
SECTION 21 TOWNSHIP 23 SOUTH RANGE 12 WEST W.M.  
COOS COUNTY, OREGON

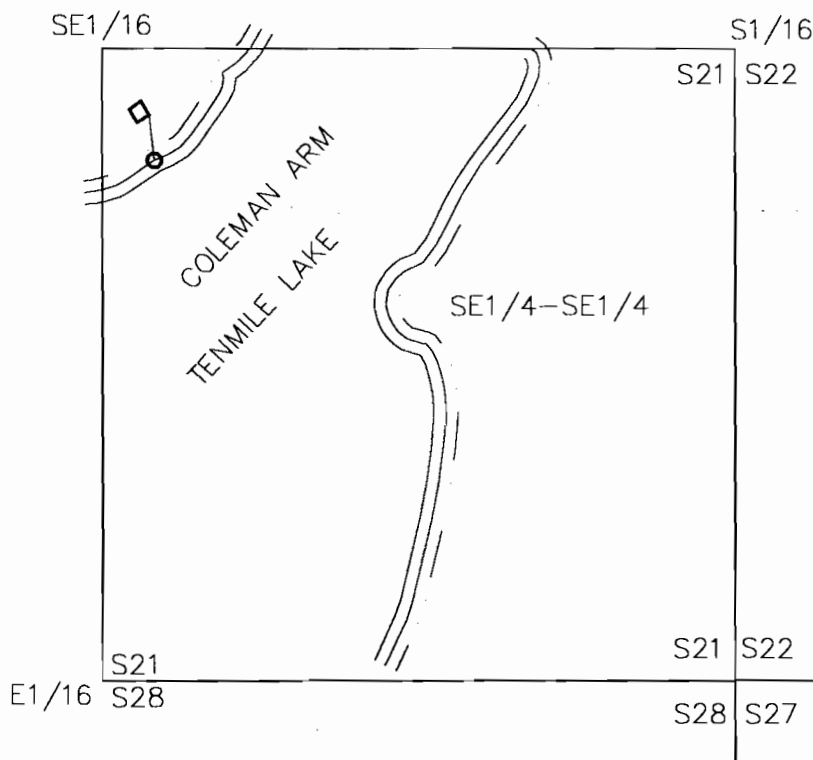


SCALE 1" = 400'

P.O.D. BEARS S25°15'45"E 257' FROM SE 1/16 CORNER

## LEGEND

- HOME
- POINT OF DIVERSION

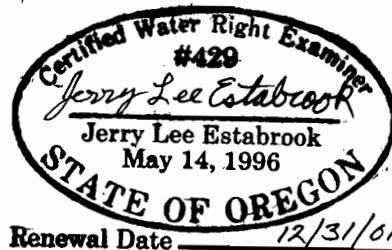

## EXAMINERS DISCLAIMER STATEMENT

THE PREPARATION OF THIS MAP WAS FOR THE PURPOSE OF IDENTIFYING THE LOCATION OF THE WATER RIGHT ONLY AND HAS NO INTENT TO PROVIDE DIMENSIONS OR LOCATION OF PROPERTY OWNERSHIP LINES.

**RECEIVED**

SEP 18 2000

WATER RESOURCES DEPT.  
SALEM, OREGON

APPLICATION NO. S-73340  
PERMIT NO. 52109