

**BENEFICIAL USE MAP  
FINAL PROOF SURVEY**

Located in the SE1/4 SE1/4 of  
Section 21, Township 23 South,  
Range 12 West, W. M.  
Coos County, Oregon

**RECEIVED**

MAR 04 1998

WATER RESOURCES DEPT.  
SALEM, OREGON

1" = 200'  
ASSESSOR SCALE

Prepared For: Raleigh & Terri Wirth  
Prepared By: Dennis Goude  
Surveyed: September 20, 1997  
Application S-73405 Permit 52103

**LEGEND**

P.O.D.


P.O.B.

PIPE

PROPERTY

LINE

RESEDENCE

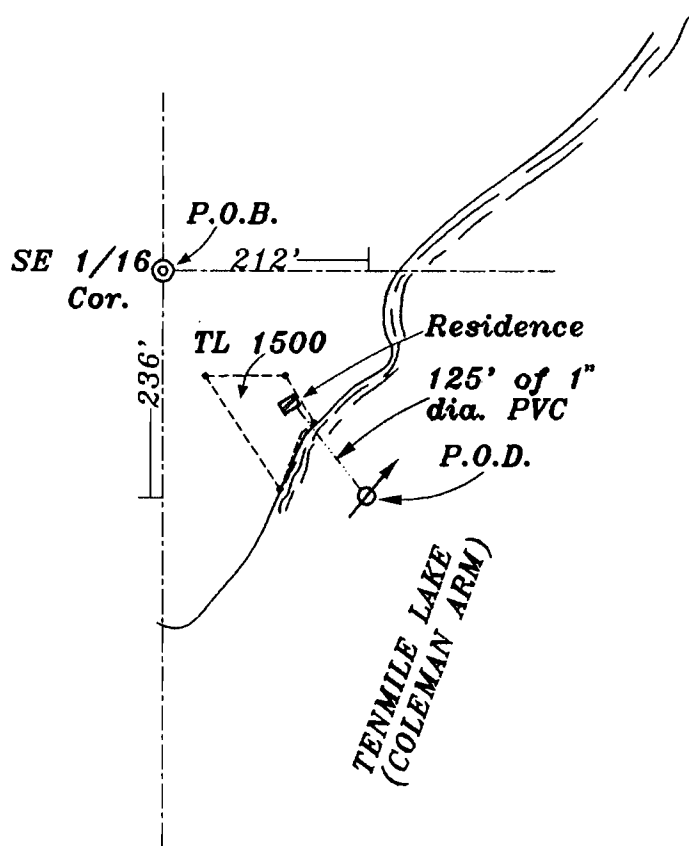

**NOTE:**

The P.O.D. is a 1/2 HP  
submersible pump and is  
located 212 feet east and  
236 feet south of the  
SE 1/16 corner.



EXPIRES 06/30/99

**EXAMINERS DISCLAIMER STATEMENT**

The preparation of this map was for the purpose of  
identifying the location of the Water Right only and  
has no intent to provide dimensions or location of  
property ownership lines.

**Stuntzner Engineering  
& Forestry, L.L.C.**

ENGINEERING • LAND SURVEYING • FORESTRY  
PLANNING • WATER RIGHTS

705 South 4th St.  
Post Office Box 118  
Coos Bay, Oregon 97420

Phone: (541) 267-2872  
Fax: (541) 267-0588

|              |                   |              |                  |
|--------------|-------------------|--------------|------------------|
| Drawn By:    | Dennis Goude      | Date:        | February 5, 1998 |
| Checked By:  | Don Jones         | Drawing No.: | 97-185           |
| Designed By: |                   | Revised:     |                  |
| Job Name:    | Wirth Water Right |              | Sheet 1 of 1     |