


FINAL PROOF SURVEY

Portions of the NW1/4 of the SE1/4
Section 04 Township 23S Range 12W W.M.

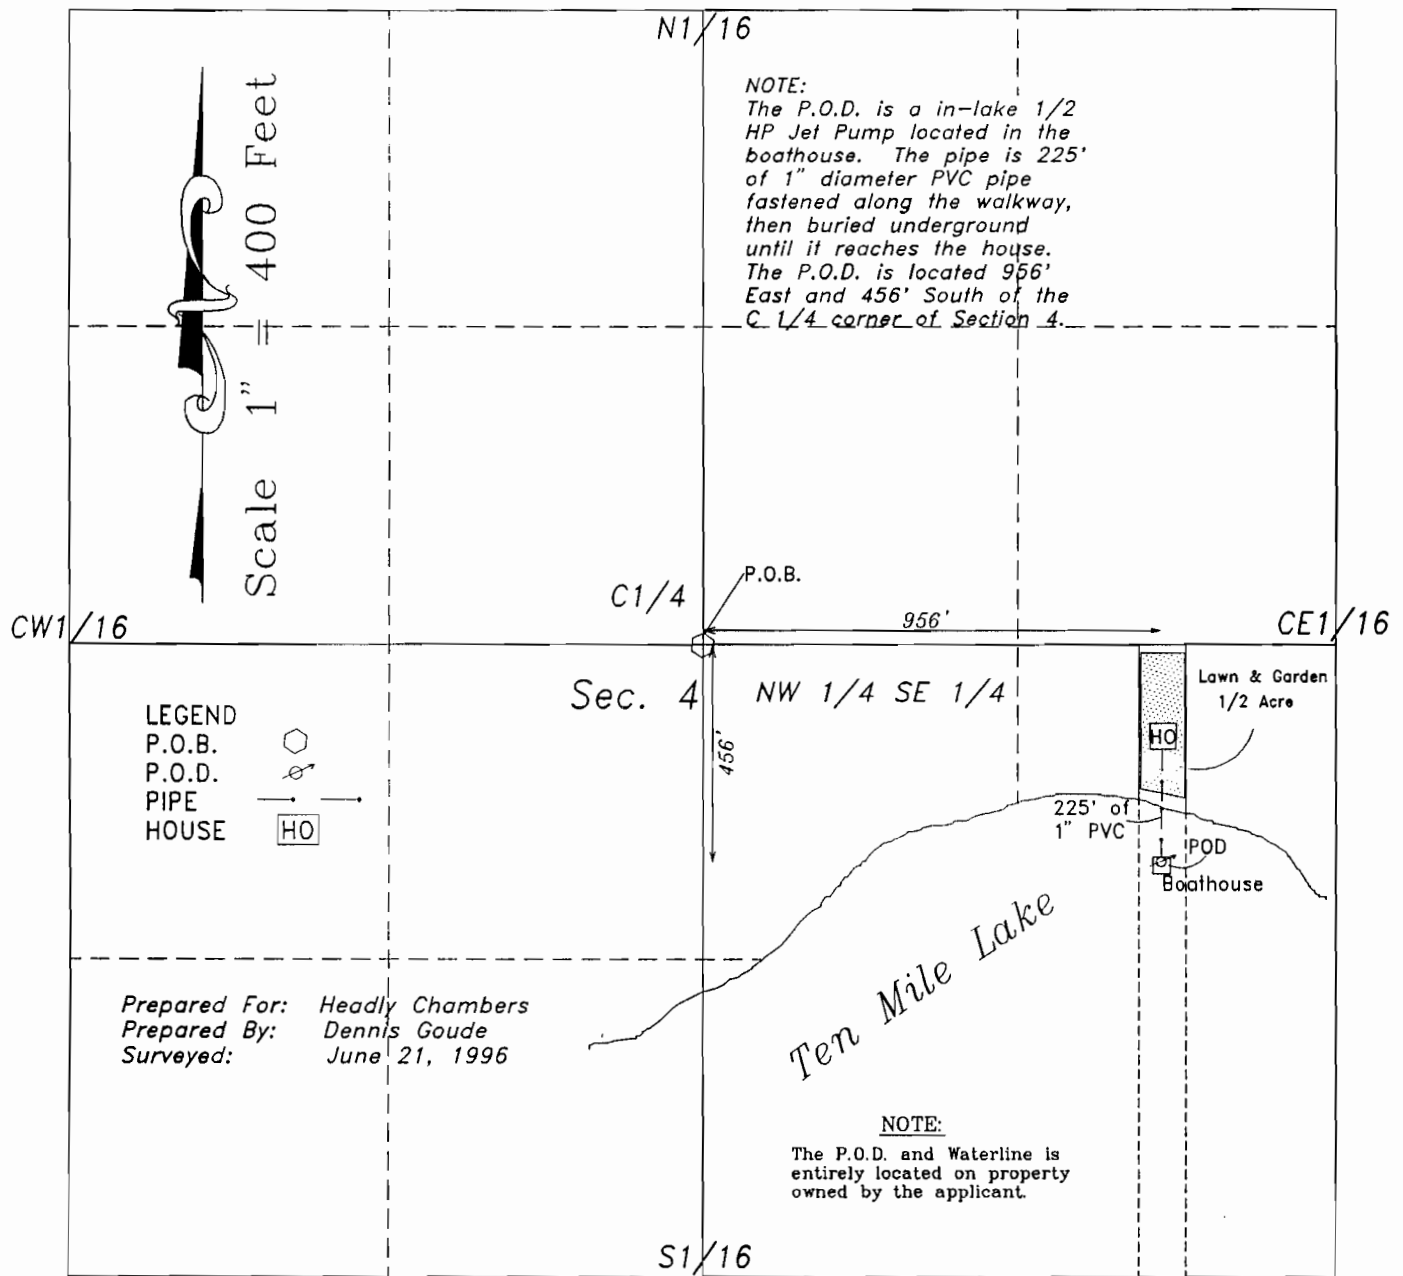


EXAMINERS DISCLAIMER STATEMENT

The preparation of this map was for the purpose of identifying the location of the Water Right only and has no intent to provide dimensions or location of property ownership lines.

Stuntzner Engineering & Forestry

705 So. 4th Street
P.O. Box 118
Coos Bay, Oregon 97420
Phone (541) 267-2872
Fax (541) 267-0588

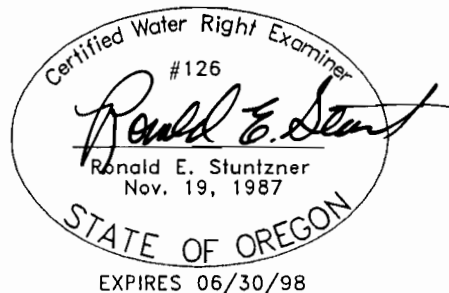

Application No. S-73616

Permit No. 52111