


RECEIVED

APR - 3 2000

CLAIM OF BENEFICIAL USE FINAL PROOF MAP

Located in the SW $\frac{1}{4}$ NW $\frac{1}{4}$ of Section 22
Township 23 South, Range 12 West, W.M.
Coos County, Oregon
Application S-73751 Permit 52105

WATER RESOURCES DEPT.
SALEM, OREGON

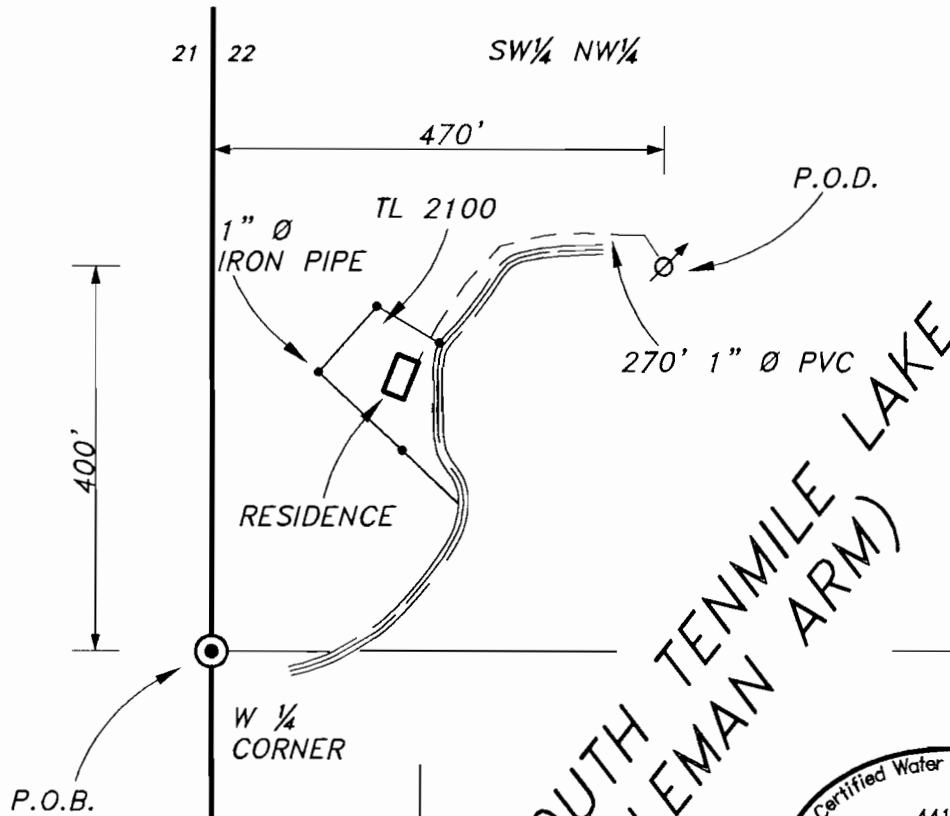

NOTE:
The P.O.D. is an
inlake 3/4 HP pump
located 400 feet
North and 470 feet
East of the West
1/4 corner of Sec. 22.



LEGEND

P.O.B.

P.O.D.

PIPE

RESIDENCE

Prepared For: Willard G. & Sally Reeve
Prepared By: Dennis Goude
Date Prepared: February 28, 2000

EXAMINERS DISCLAIMER STATEMENT

The preparation of this map was for the purpose of
identifying the location of the Water Right only and
has no intent to provide dimensions or location of
property ownership lines.

Stuntzner Engineering
& Forestry, L.L.C.

ENGINEERING • LAND SURVEYING • FORESTRY
PLANNING • WATER RIGHTS

705 South 4th St.
Post Office Box 116
Coos Bay, Oregon 97420

Phone: (541) 267-2872
Fax: (541) 267-0588