


Tax Lot No. TL2300 23 12 21DA
Section 21 Township 23S Range 12W W.M.
Coos County

RECEIVED

MAY 13 1999

WATER RESOURCES DEPT.
SALEM, OREGON

Scale 1" = 400'

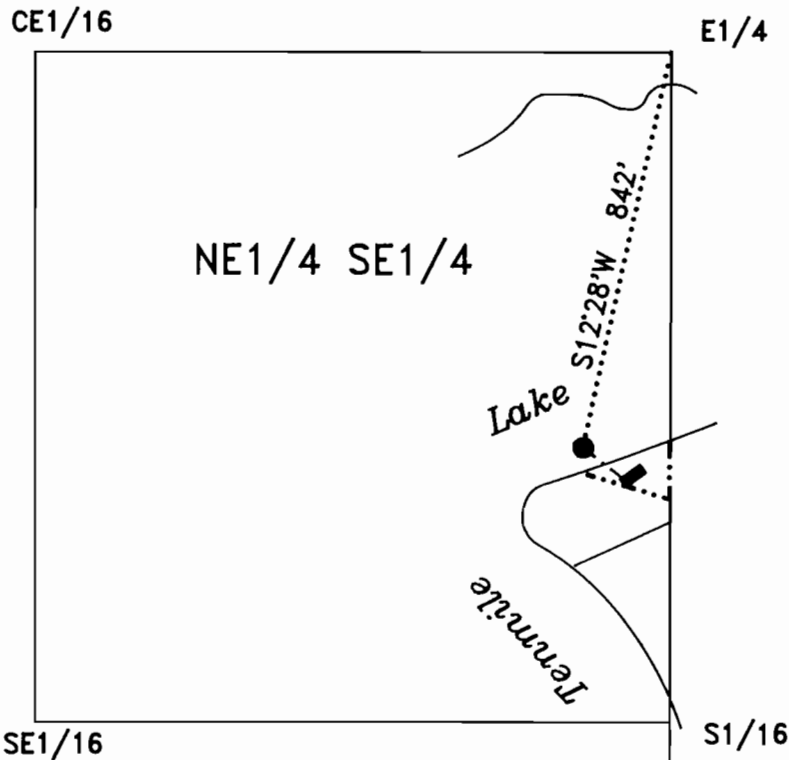


LEGEND

- HOME
- POINT OF DIVERSION
- WATERLINE
- PROPERTY LINE

EXAMINERS DISCLAIMER STATEMENT

The preparation of this map was for the purpose of identifying the location of the Water Right only and has no intent to provide dimensions or location of property ownership lines.

S21 S22
S28 S27

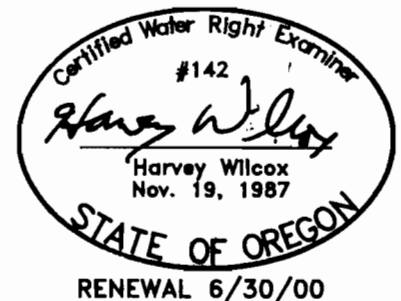

FINAL PROOF SURVEY

IN THE NAME OF

James M. and Sharon V. Forney

Surveyed on 5/1/99 by H.A. Wilcox

Application No. S-73825
Permit No. 52106