


Section 21 Township 23 S Range 12 W W.M.

TL 1200 Located in the SE1/4 SE1/4
Coos County, Oregon

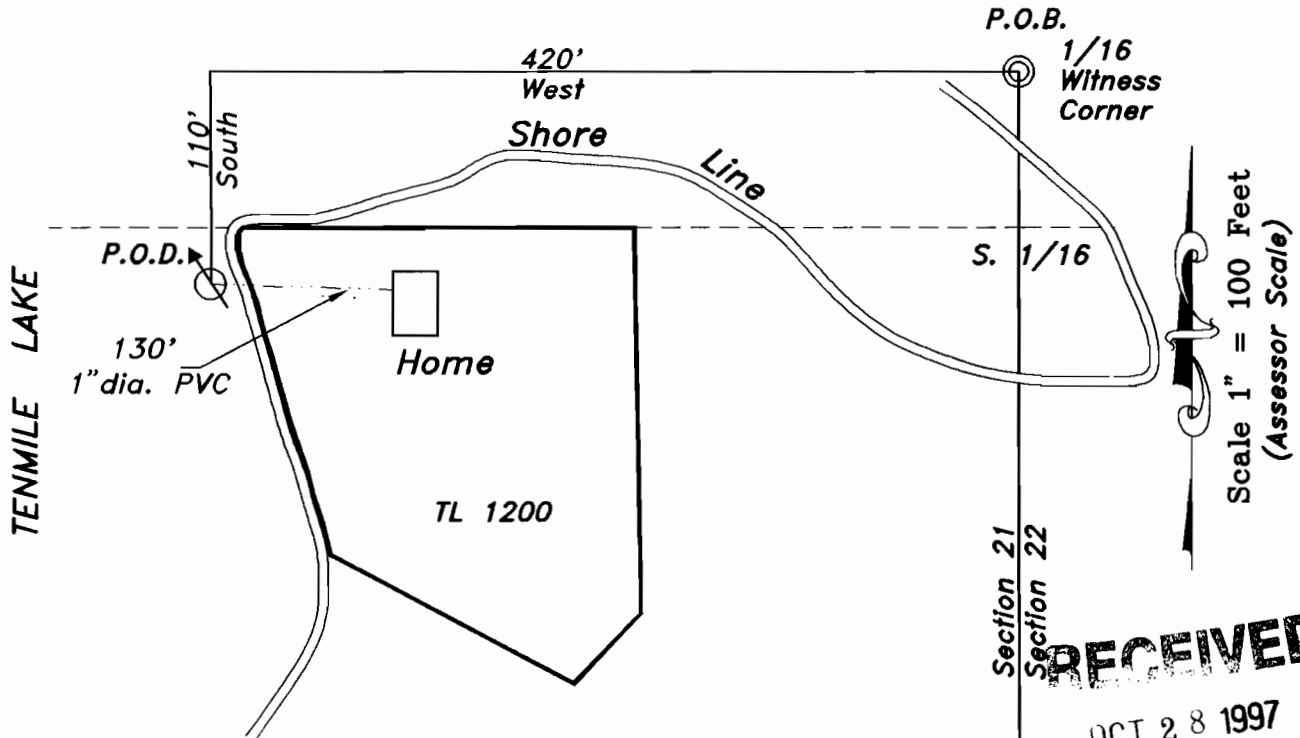

LEGEND

P.O.D.



P.O.B.

PIPE

HOME

PROP

LINE

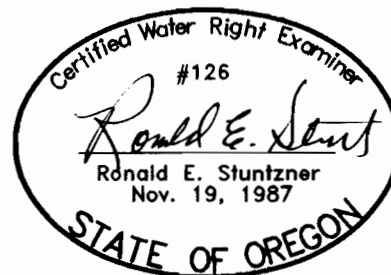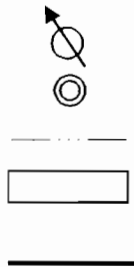

EXPIRES 06/30/98

Prepared For: R.T. Parks
Prepared By: Dennis Goude
Surveyed: October 16, 1997

FINAL PROOF SURVEY

Application No. S-73826
Permit No. 52614

Stuntzner Engineering

& Forestry, LLC

ENGINEERING * LAND SURVEYING * FORESTRY
PLANNING * WATER RIGHTS

705 South 4th St.
Post Office Box 118
Coos Bay, Oregon 97420


Phone (541) 267-2872
Fax (541) 267-0588

EXAMINERS DISCLAIMER STATEMENT

The preparation of this map was for the purpose of identifying the location of the Water Right only and has no intent to provide dimensions or location of property ownership lines.

Section 21 Township 23 S Range 12 W W.M.

TL 1200 Located in the SE1/4 SE1/4
Coos County, Oregon

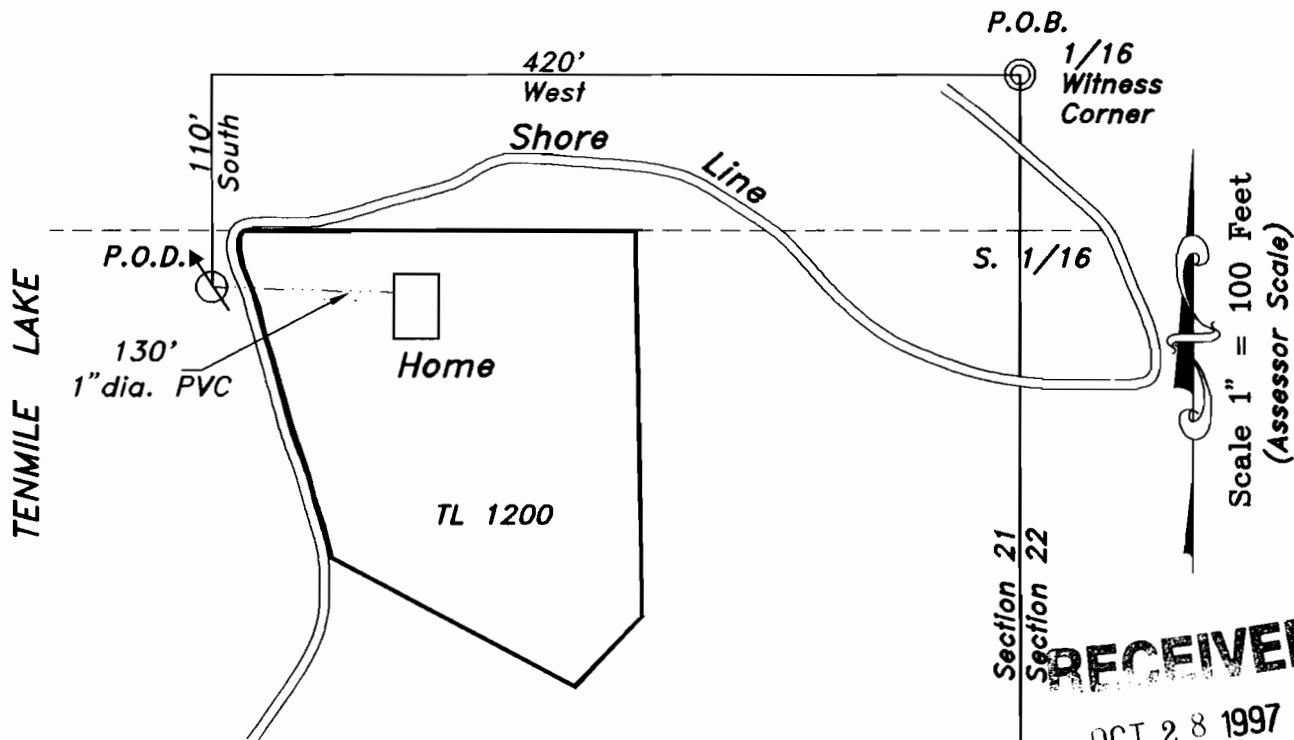

LEGEND

P.O.D.

P.O.B.

PIPE

HOME

PROP

LINE



Prepared For: R.T. Parks
Prepared By: Dennis Goude
Surveyed: October 16, 1997

FINAL PROOF SURVEY

Application No. S-73826
Permit No. 52614

Stuntzner Engineering

& Forestry, LLC

ENGINEERING * LAND SURVEYING * FORESTRY
PLANNING * WATER RIGHTS

705 South 4th St.
Post Office Box 118
Coos Bay, Oregon 97420

Phone (541) 267-2872
Fax (541) 267-0588

EXAMINERS DISCLAIMER STATEMENT

The preparation of this map was for the purpose of identifying the location of the Water Right only and has no intent to provide dimensions or location of property ownership lines.