


Section 17 Township 23S Range 12W W.M.
Coos County

C1/4 CE1/16 E1/4

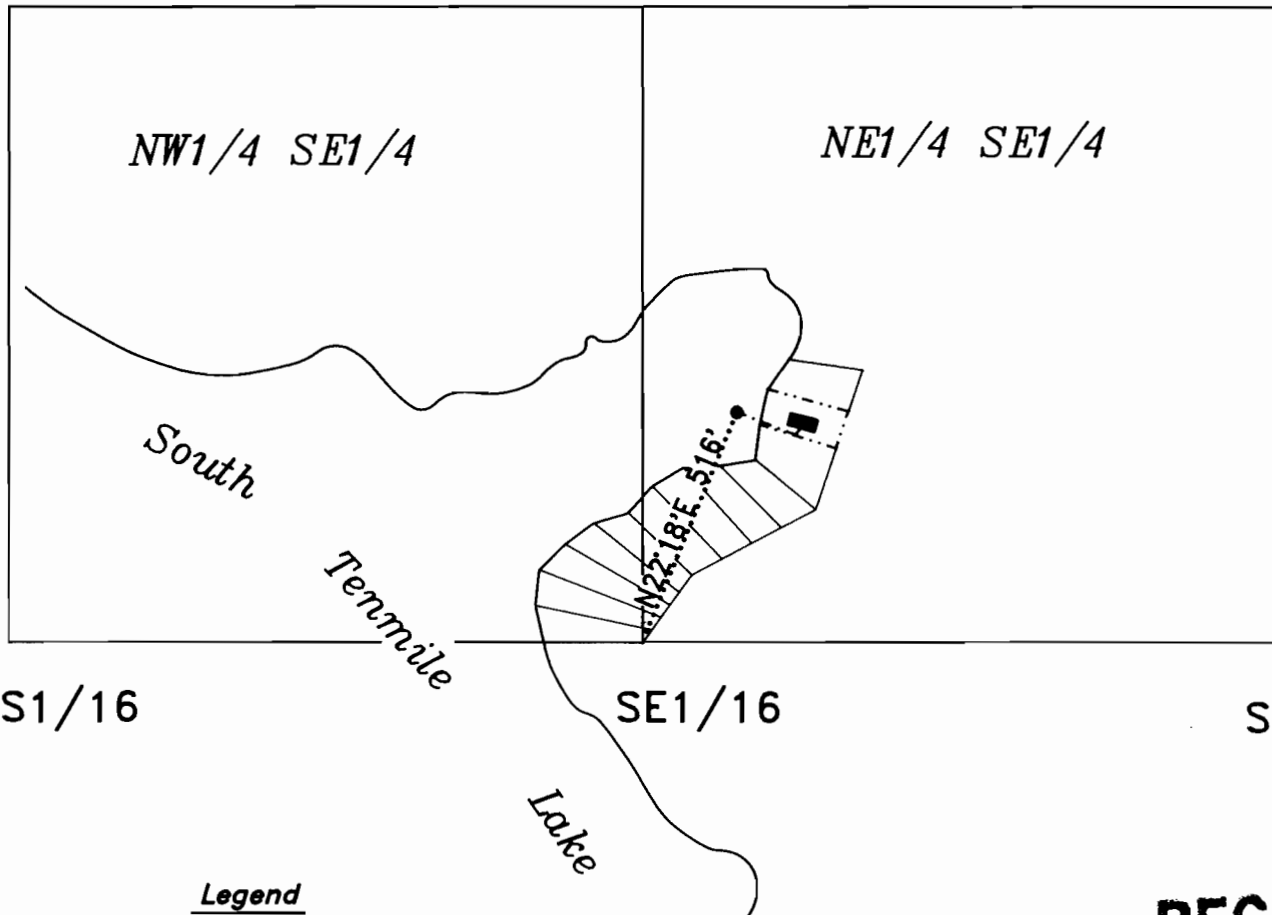

Legend

- P.O.D.
- Home
- Property Line
- Waterline


RECEIVED

OCT - 1 1996

WATER RIGHT EXAMINER

EXAMINERS DISCLAIMER STATEMENT

The preparation of this map was for the purpose of identifying the location of the Water Right only and has no intent to provide dimensions or location of property ownership lines.

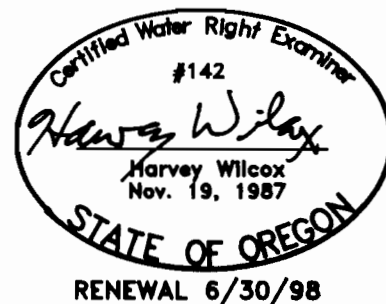

FINAL PROOF SURVEY

IN THE NAME OF

William & Norma Downton

Surveyed on 8/15/96 by H.A. Wilcox

Application No. S-74265

Permit No. 52593