


Tax Lot 400 Tax Account No. 234.00
Section 17 Township 23S Range 12W W.M.
Coos County

RECEIVED

JAN 29 1997

WATER RESOURCES DEPT.
SALEM, OREGON

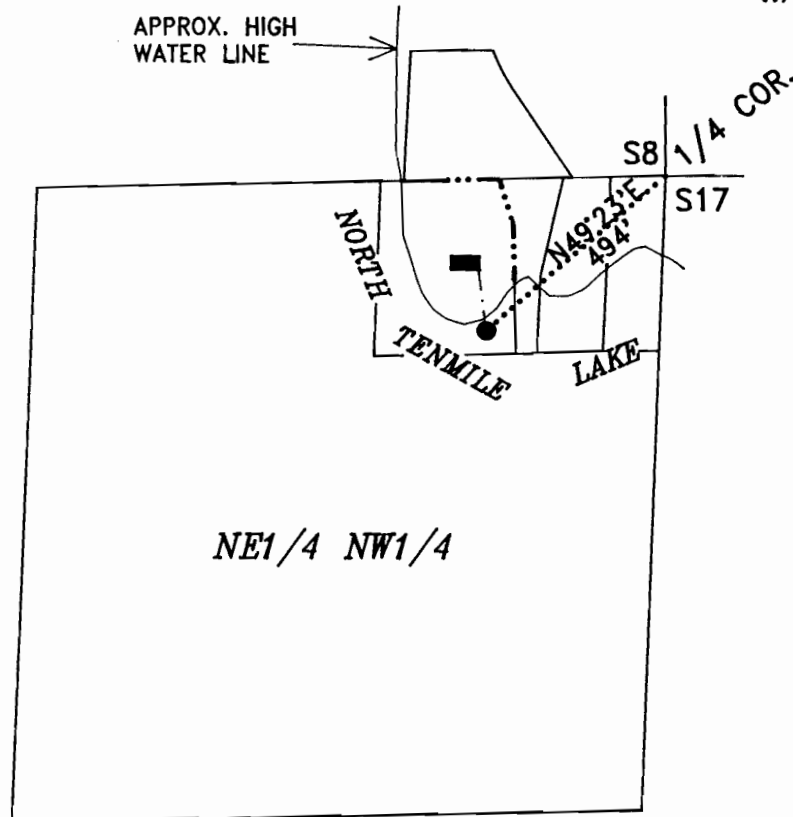

Scale 1" = 400'

Legend

- P.O.D.
- Property Line
- Waterline
- House


EXAMINERS DISCLAIMER STATEMENT

The preparation of this map was for the purpose of identifying the location of the Water Right only and has no intent to provide dimensions or location of property ownership lines.

FINAL PROOF SURVEY

IN THE NAME OF

Charles P. McKay

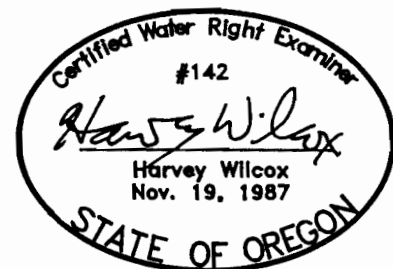

RENEWAL 6/30/98

Surveyed on 11/26/96 by H.A. Wilcox

Application No. S-80847

Permit No. 52745