


Tax Lot No. TL101 23 12 17CB
Section 17 Township 23S Range 12W
Coos County

RECEIVED

DEC 24 1997
WATER RESOURCES DEPT.
SALEM, OREGON

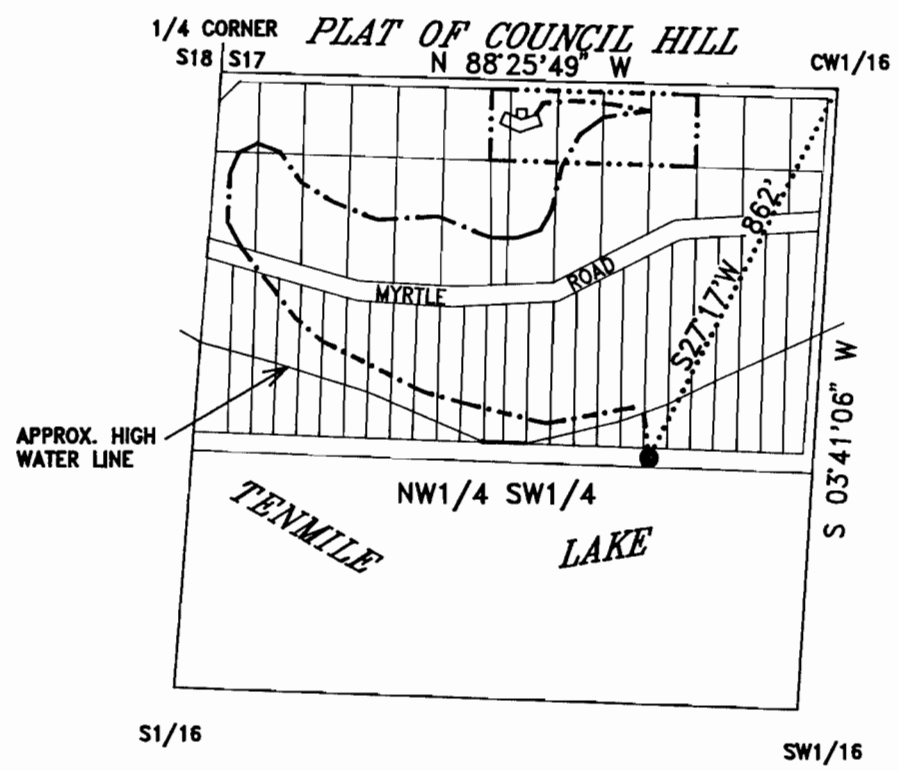

Scale 1" = 400'

Legend

- P.O.D.
- - - - - Property Line
- - - - - Waterline
- House

EXAMINERS DISCLAIMER STATEMENT

The preparation of this map was for the purpose of identifying the location of the Water Right only and has no intent to provide dimensions or location of property ownership lines.

FINAL PROOF SURVEY
IN THE NAME OF
Merle & Emma Dunbar

Certified Water Right Examiner
#142
Harvey Wilcox
Harvey Wilcox
Nov. 19, 1987
STATE OF OREGON
RENEWAL 6/30/98

Surveyed on 11/24/97 by H.A. Wilcox

Application No. S-80906
Permit No. 53037