



Tax Lot TL1100 Tax Account No. 75546.00  
 Section 29 Township 23S Range 12W W.M.  
 Coos County

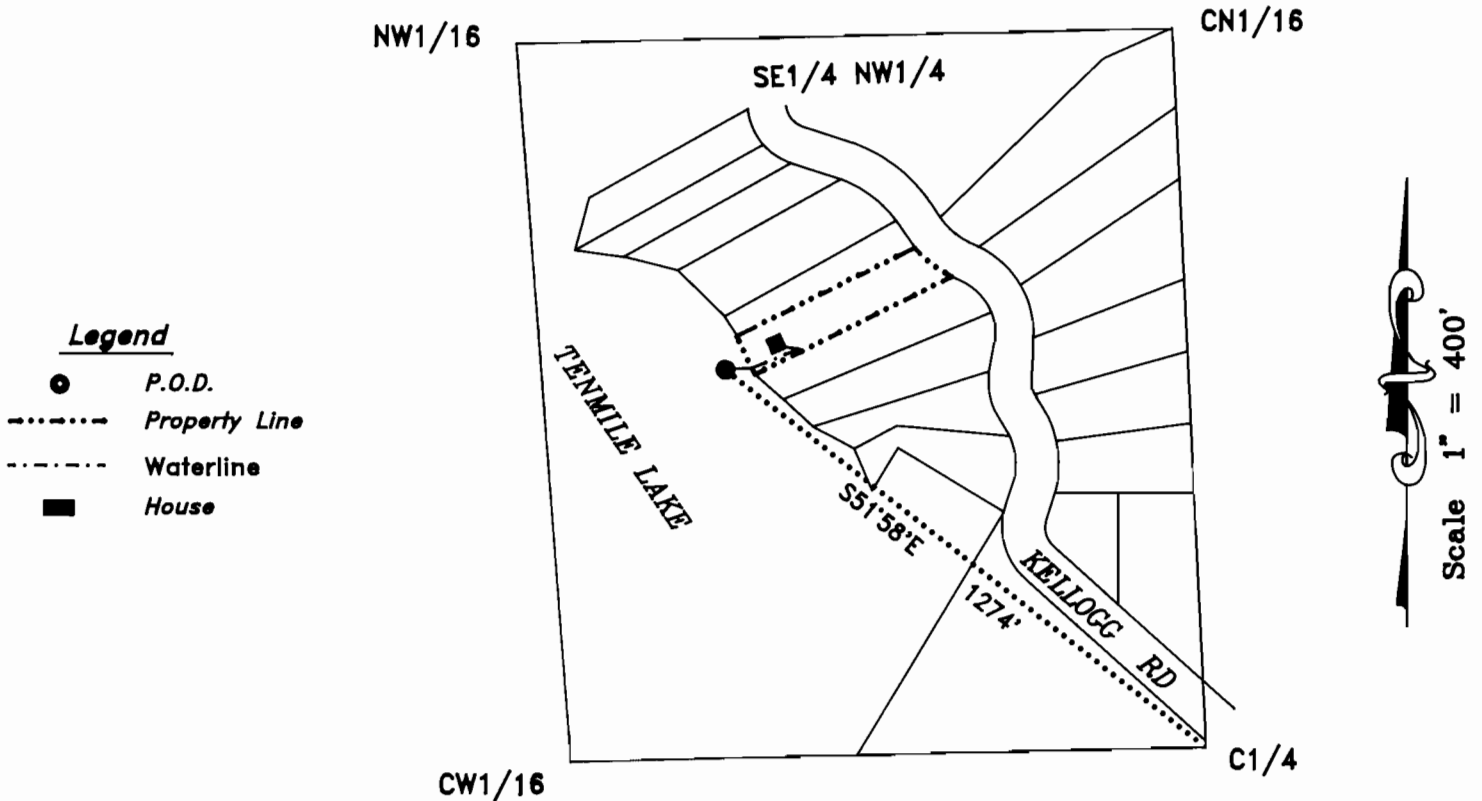

**EXAMINERS DISCLAIMER STATEMENT**

The preparation of this map was for the purpose of identifying the location of the Water Right only and has no intent to provide dimensions or location of property ownership lines.

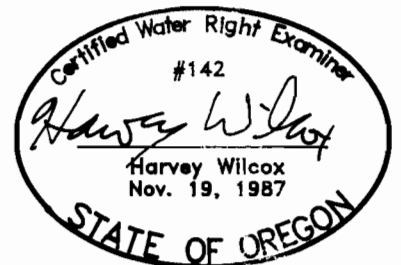

RENEWAL 6/30/98

**FINAL PROOF SURVEY**  
 IN THE NAME OF

William David and Rita J. Emblen

Surveyed on 2/10/97 by H.A. Wilcox

Application No. S-80909  
 Permit No. 52954