


Tax Lot TL1400 Tax Account No. 153.03
Section 8 Township 23S Range 12W W.M.
Coos County

RECEIVED


FEB 3 1997

WATER RESOURCES DEPT.
SALEM, OREGON

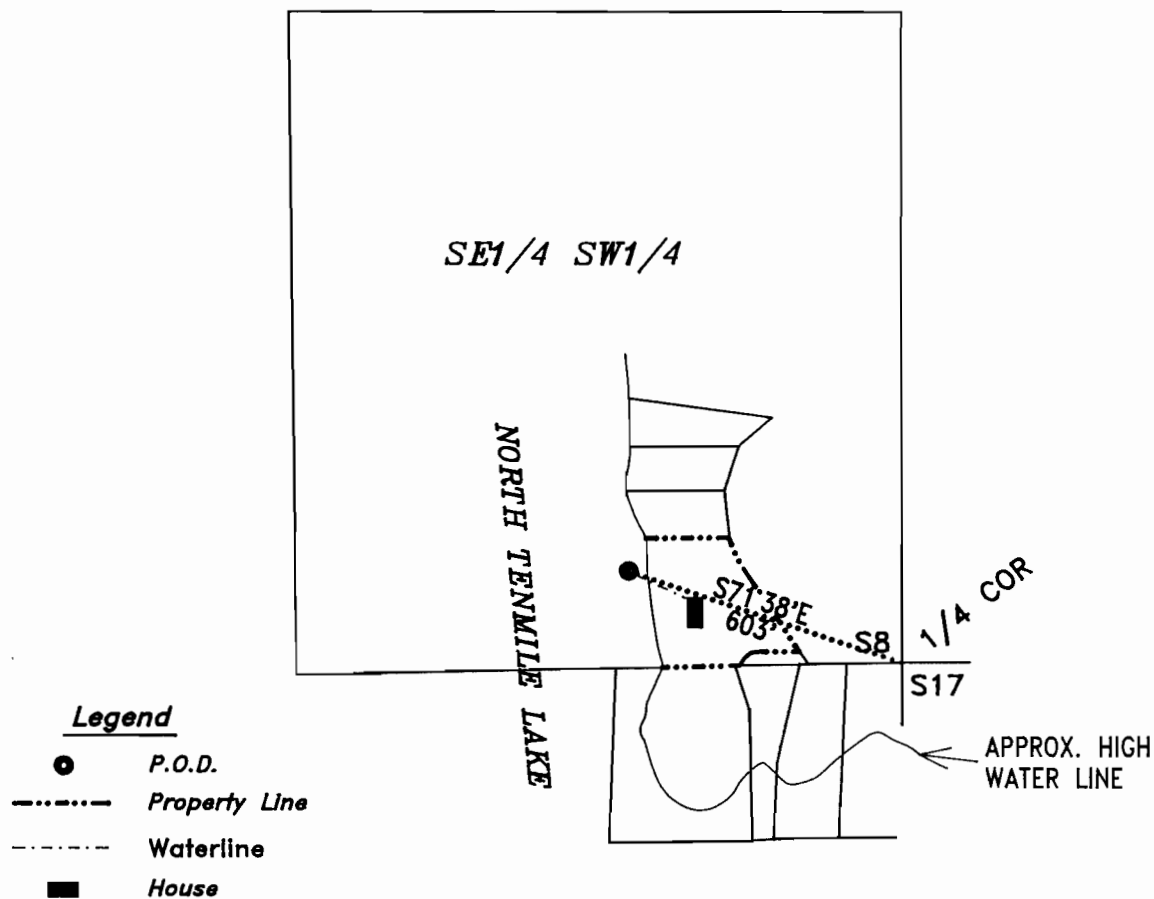

EXAMINERS DISCLAIMER STATEMENT

The preparation of this map was for the purpose of identifying the location of the Water Right only and has no intent to provide dimensions or location of property ownership lines.

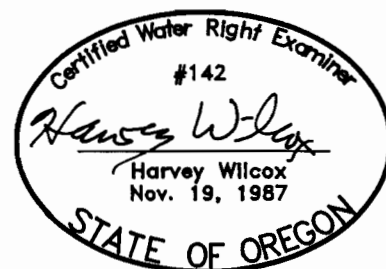

RENEWAL 6/30/98

FINAL PROOF SURVEY

IN THE NAME OF

Charles R. and Betty M. Heimlich Trustees

Surveyed on 11/26/96 by H.A. Wilcox

Application No. S-80911

Permit No. 53018