


Tax Lot No. TL1000 23 12 21
Section 21 Township 23S Range 12W W.M.
Coos County

RECEIVED

SEP 27 1999

WATER RESOURCES DEPT
SALEM, OREGON

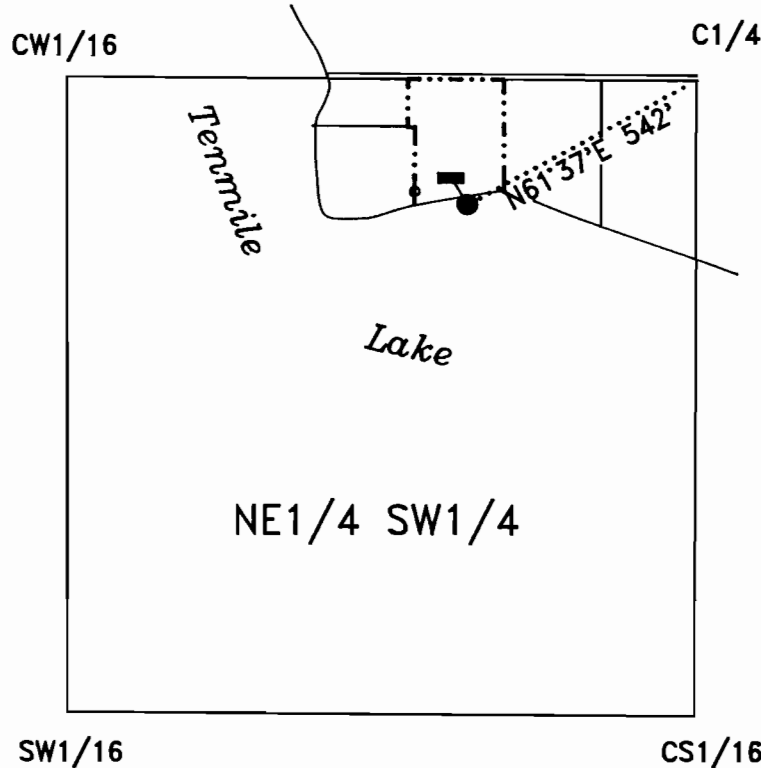


Scale 1" = 400'

LEGEND

- HOME
- POINT OF DIVERSION
- WATERLINE
- PROPERTY LINE

EXAMINERS DISCLAIMER STATEMENT

The preparation of this map was for the purpose of identifying the location of the Water Right only and has no intent to provide dimensions or location of property ownership lines.

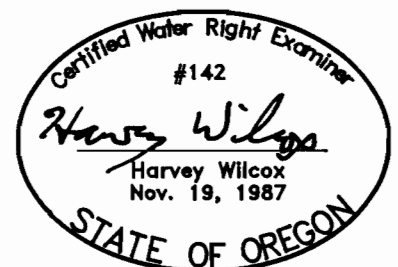

RENEWAL 6/30/00

FINAL PROOF SURVEY
IN THE NAME OF
David and Ronda Amatore

Surveyed on 8/22/99 by H.A. Wilcox

Application No. S-80918
Permit No. 52861