

Tax Lot No. TL1200 23 12 17
Section 17 Township 23S Range 12W
Coos County


W.M.
RECEIVED

JAN - 6 1908

WATER RESOURCES DEPT.
SALEM, OREGON

CS1/16

S1/4

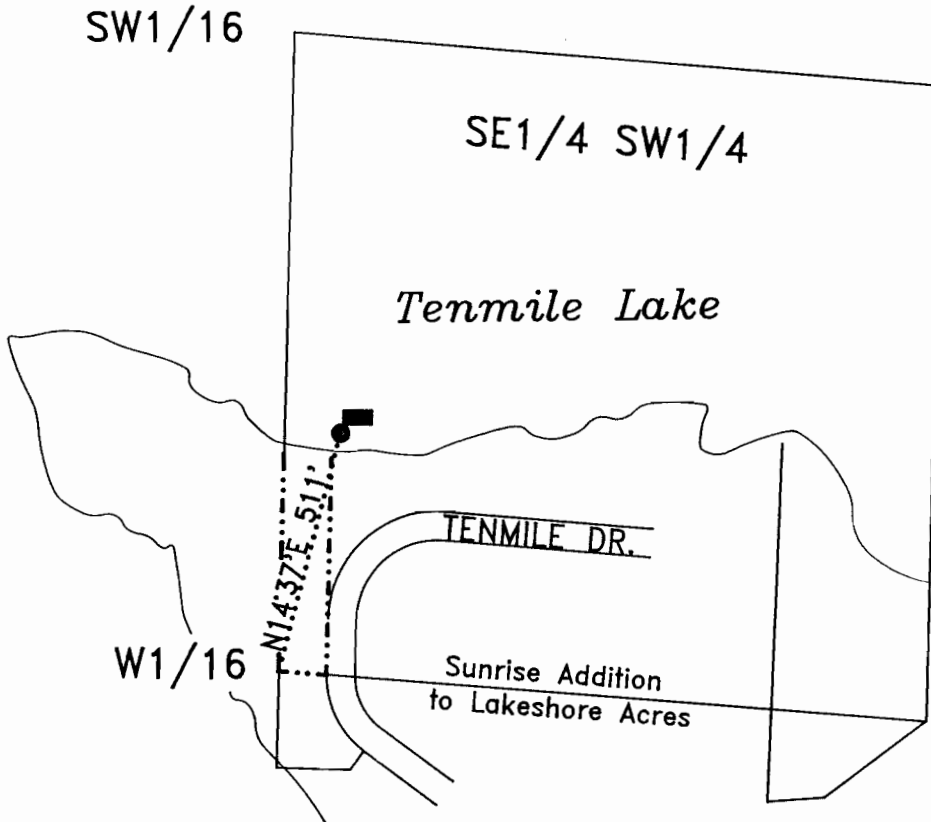


Legend

- P.O.D.
- Property Line
- Waterline
- Boat House

EXAMINERS DISCLAIMER STATEMENT

The preparation of this map was for the purpose of identifying the location of the Water Right only and has no intent to provide dimensions or location of property ownership lines.

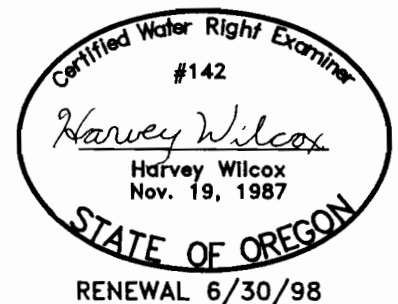

FINAL PROOF SURVEY
IN THE NAME OF
Thomas D. Barrett

Surveyed on 11/13/97 by H.A. Wilcox

Application No. S-80920
Permit No. 52979