

Tax Lot 3402 TL1400 Tax Account No. 75377.00
Section 8 Township 23S Range 12W W.M.
Coos County


RECEIVED

FEB 28 1997

SW1/16

CS1/16

WATER RESOURCES DEPT.
SALEM, OREGON

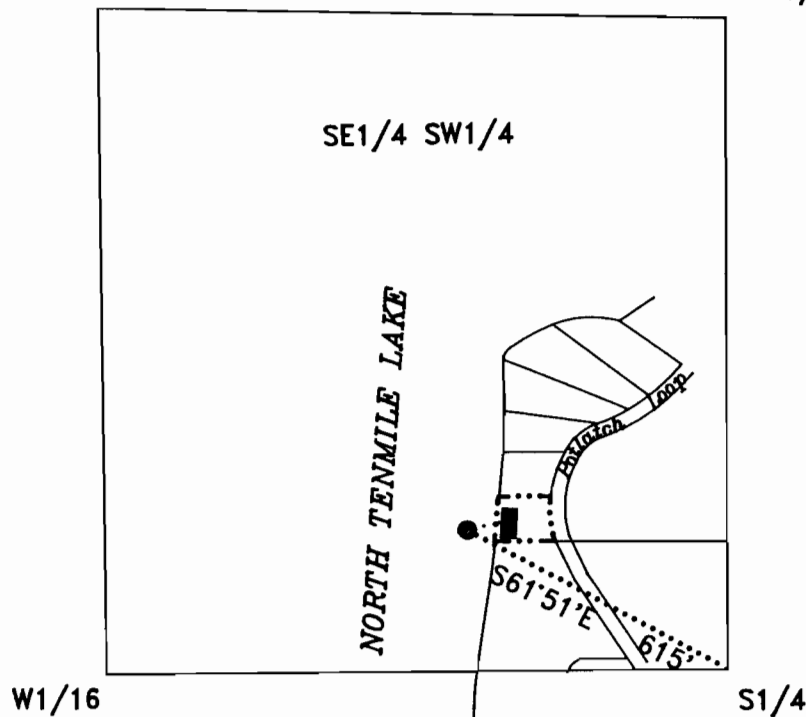

Scale 1" = 400'

Legend

- P.O.D.
- Property Line
- Waterline
- House

EXAMINERS DISCLAIMER STATEMENT


The preparation of this map was for the purpose of identifying the location of the Water Right only and has no intent to provide dimensions or location of property ownership lines.

FINAL PROOF SURVEY

IN THE NAME OF

Daniel H. and Eleanor P. Jordan

Surveyed on 2/10/97 by H.A. Wilcox

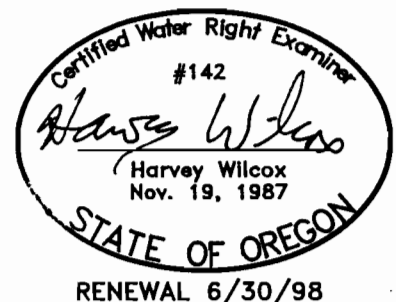

Application No. S-80925
Permit No. 53050