


Section 17 Township 23 S Range 12 W W.M.

Coos County
TL 200

RECEIVED

SEP 10 1997

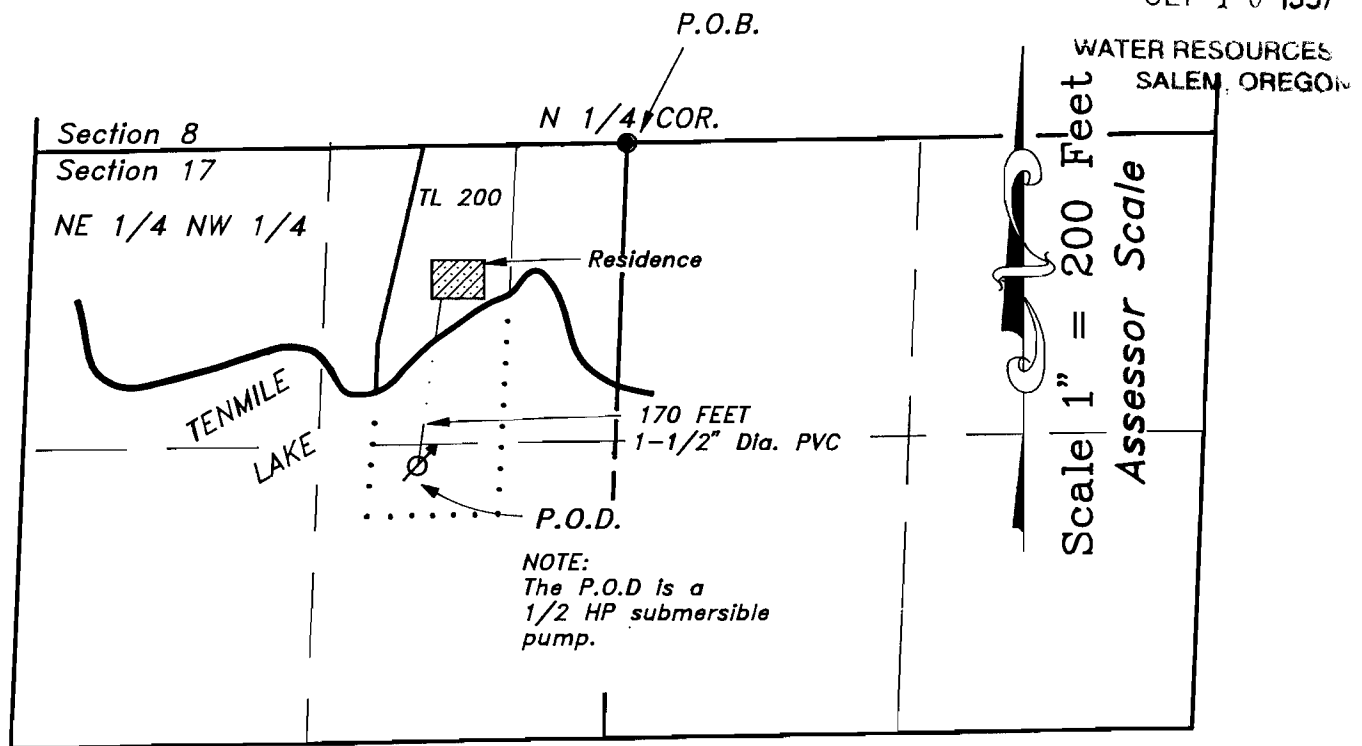

Legend


P.O.D.



P.O.B.



PROPERTY LINE

 

PIPE




NOTE:

The P.O.D. is located 335 feet South and 218 feet West of the North 1/4 corner of Section 17, Township 23 South, Range 12 West, W.M.

EXAMINERS DISCLAIMER STATEMENT

The preparation of this map was for the purpose of identifying the location of the Water Right only and has no intent to provide dimensions or location of property ownership lines.

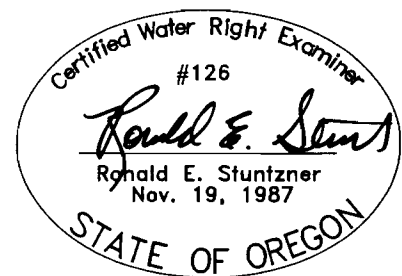

FINAL PROOF SURVEY

EXPIRES 06/30/98

Prepared For: Judith A. Reeves
Prepared By: Dennis Goude
Surveyed: July 23, 1997

Application No. S-80936
Permit No. 52874