

RECEIVED

NOV 04 1998

WATER RESOURCES DEPT.
SALEM, OREGON

1" = 100 FEET

Assessor Scale


BENEFICIAL USE MAP
FINAL PROOF SURVEY

Located in the SW1/4 SW1/4 of Section 9,
Township 23 South, Range 12 West, W.M.

Coos County, Oregon

Application # S-80937

Permit #52566

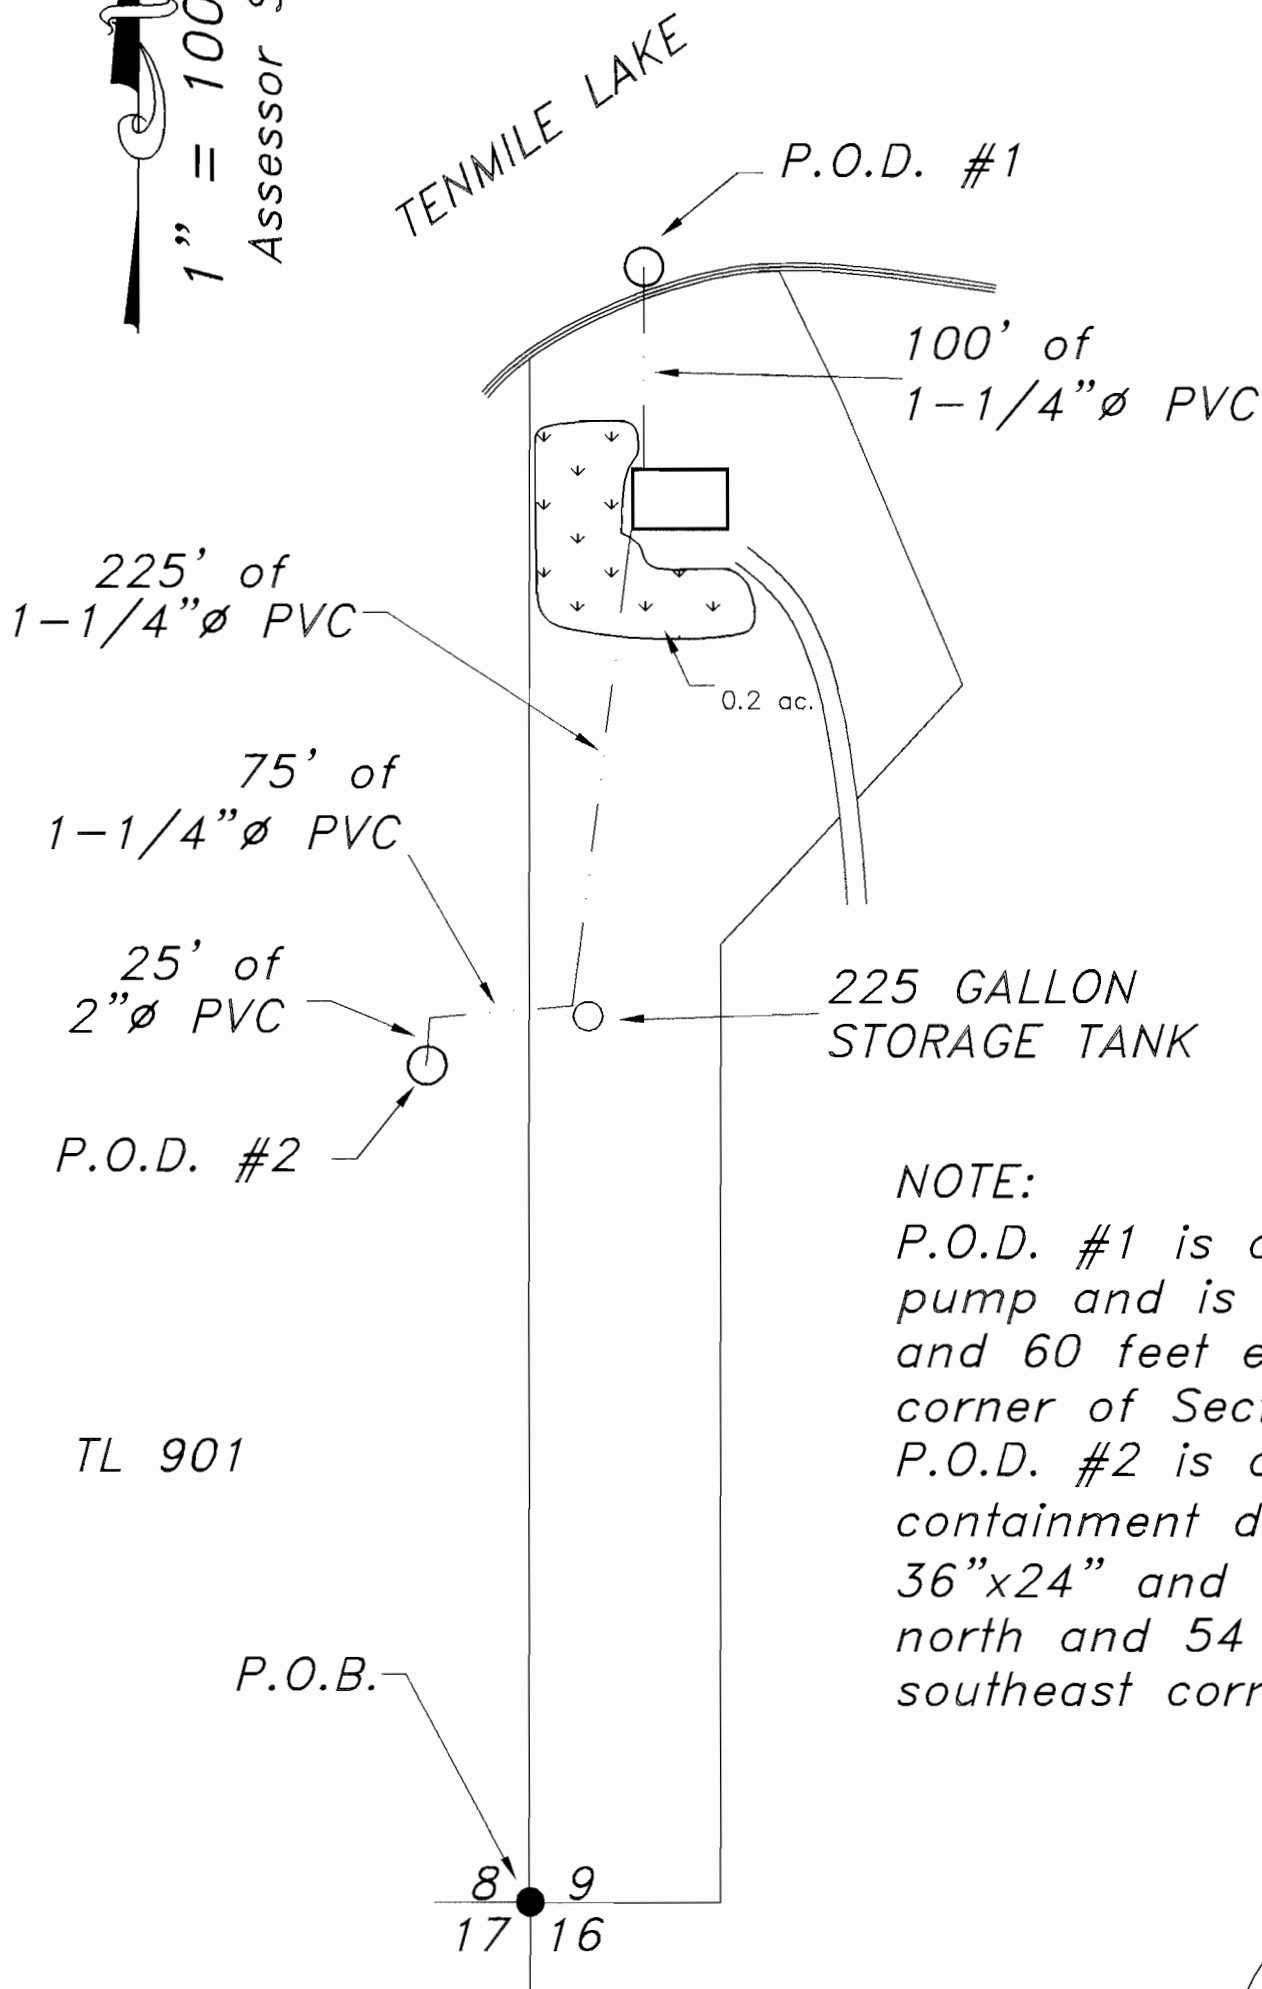

NOTE:

P.O.D. #1 is an in-lake 3/4 HP pump and is located 853 feet north and 60 feet east of the southwest corner of Section 9.

P.O.D. #2 is an in-spring concrete containment device measuring 30"x36"x24" and is located 437 feet north and 54 feet west of the southeast corner of Section 8.



EXPIRES 06/30/00

Prepared For: Gary Frazier
Prepared By: Dennis Goude
Surveyed: Dec. 22, 1995

Stuntzner Engineering
& Forestry, LLC

ENGINEERING * LAND SURVEYING * FORESTRY
PLANNING * WATER RIGHTS

705 South 4th St.
Post Office Box 118
Coos Bay, Oregon 97420

Phone (541) 267-2872
Fax (541) 267-0588

EXAMINERS DISCLAIMER STATEMENT

The preparation of this map was for the purpose of identifying the location of the Water Right only and has no intent to provide dimensions or location of property ownership lines.