


Section 17 Township 23 S Range 12 W **RECEIVED**

Coos County
TL 100

AUG 29 1997

WATER RESOURCES DEPT.
SALEM, OREGON

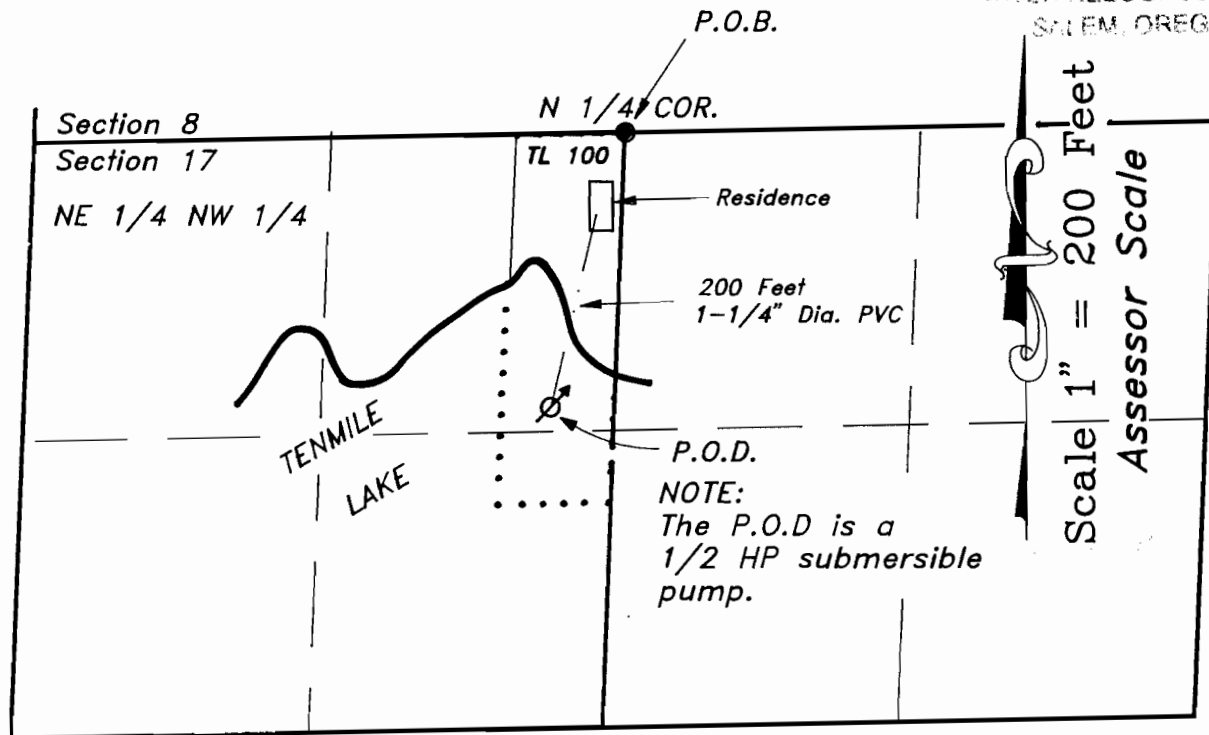

Legend

P.O.D.




P.O.B.



PROPERTY LINE



PIPE

 

NOTE:

The P.O.D. is located 295 feet South and 80 feet West of the North 1/4 corner of Section 17, Township 23 South, Range 12 West, W.M.

EXAMINERS DISCLAIMER STATEMENT

The preparation of this map was for the purpose of identifying the location of the Water Right only and has no intent to provide dimensions or location of property ownership lines.



EXPIRES 06/30/98

FINAL PROOF SURVEY

Prepared For: John & Rebecca Cahill

Prepared By: Dennis Goude

Surveyed: January 30, 1996

Application No. S-80945

Permit No. 52870