


Tax Lot No. 1900 23 12 17B

Section 17 Township 23 SOUTH Range 12 WEST W.M.
Coos County

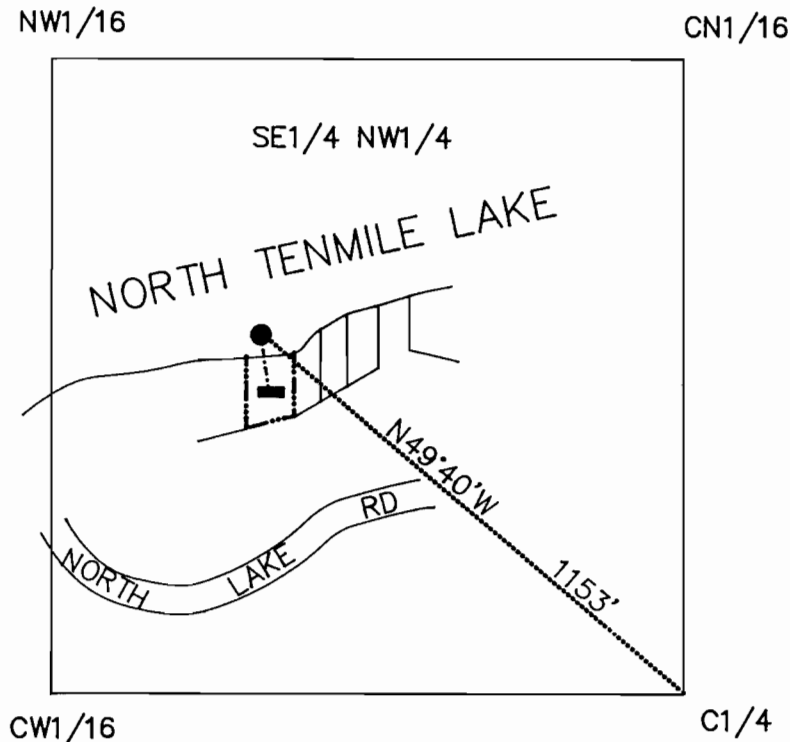

LEGEND

- HOME
- POINT OF DIVERSION
- WATERLINE
- PROPERTY LINE

EXAMINERS DISCLAIMER STATEMENT

The preparation of this map was for the purpose of identifying the location of the Water Right only and has no intent to provide dimensions or location of property ownership lines.


FINAL PROOF SURVEY
IN THE NAME OF
Richard F. Foley

Surveyed on 8/31/99 by H.A. Wilcox

RECEIVED

SEP 20 2000

WATER RESOURCES DEPT.
SALEM, OREGON

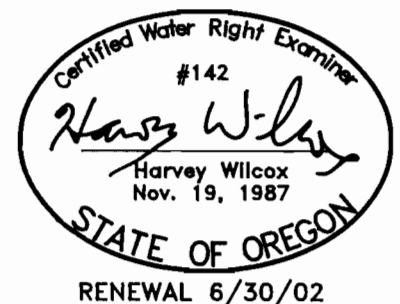

Application No. S-80957
Permit No. 53088