


CLAIM OF BENEFICIAL USE MAP
FINAL PROOF SURVEY
Located in the SW1/4 SW1/4 of
Section 9, Township 23 South, Range 12 West, W.M.
Coos County, Oregon
Tax Lot 900
Application No. S-80958 Permit 53054

RECEIVED
FEB 10 1998
WATER RESOURCES DEPT.
SALEM, OREGON

Prepared For: Siegfried Emke
Prepared By: Dennis Goude
January 28, 1998

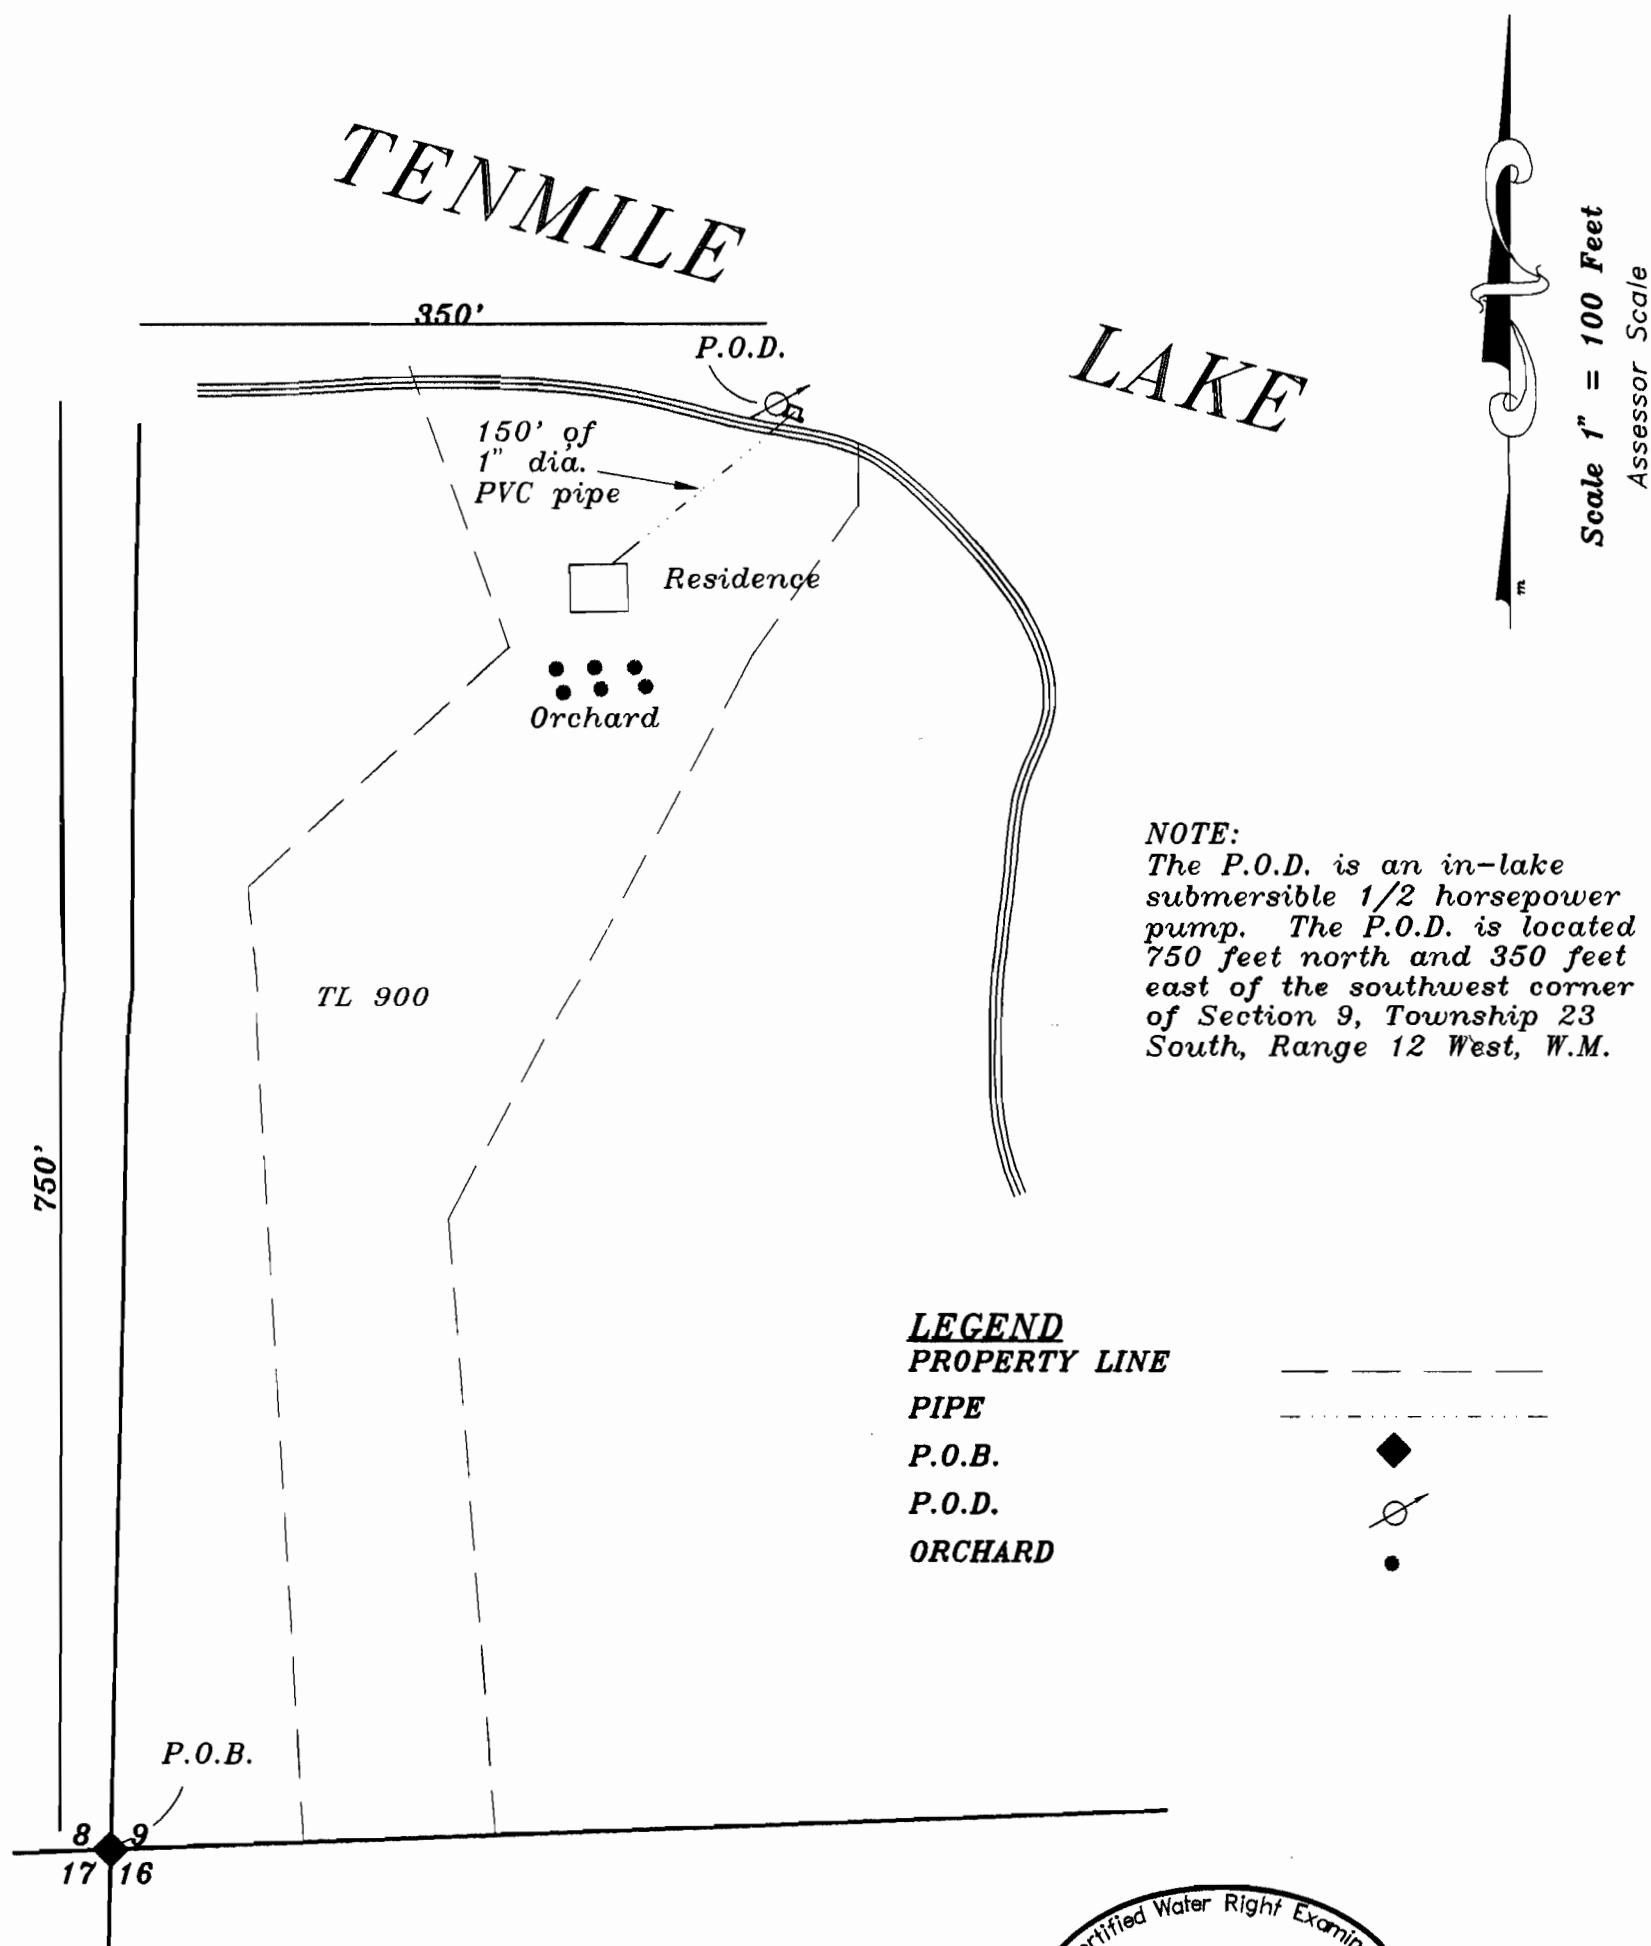

NOTE:
The P.O.D. is an in-lake
submersible 1/2 horsepower
pump. The P.O.D. is located
750 feet north and 350 feet
east of the southwest corner
of Section 9, Township 23
South, Range 12 West, W.M.

LEGEND
PROPERTY LINE
PIPE
P.O.B.
P.O.D.
ORCHARD



EXPIRES 06/30/99

Stuntzner Engineering
& Forestry, LLC
ENGINEERING * LAND SURVEYING * FORESTRY
PLANNING * WATER RIGHTS
705 South 4th St.
Post Office Box 118
Coos Bay, Oregon 97420
Phone (541) 267-2872
Fax (541) 267-0588

EXAMINERS DISCLAIMER STATEMENT
The preparation of this map was for the purpose of
identifying the location of the Water Right only and
has no intent to provide dimensions or location of
property ownership lines.