




RECEIVED

AUG 31 1998

WATER RESOURCES DEPT.
SALEM, OREGON

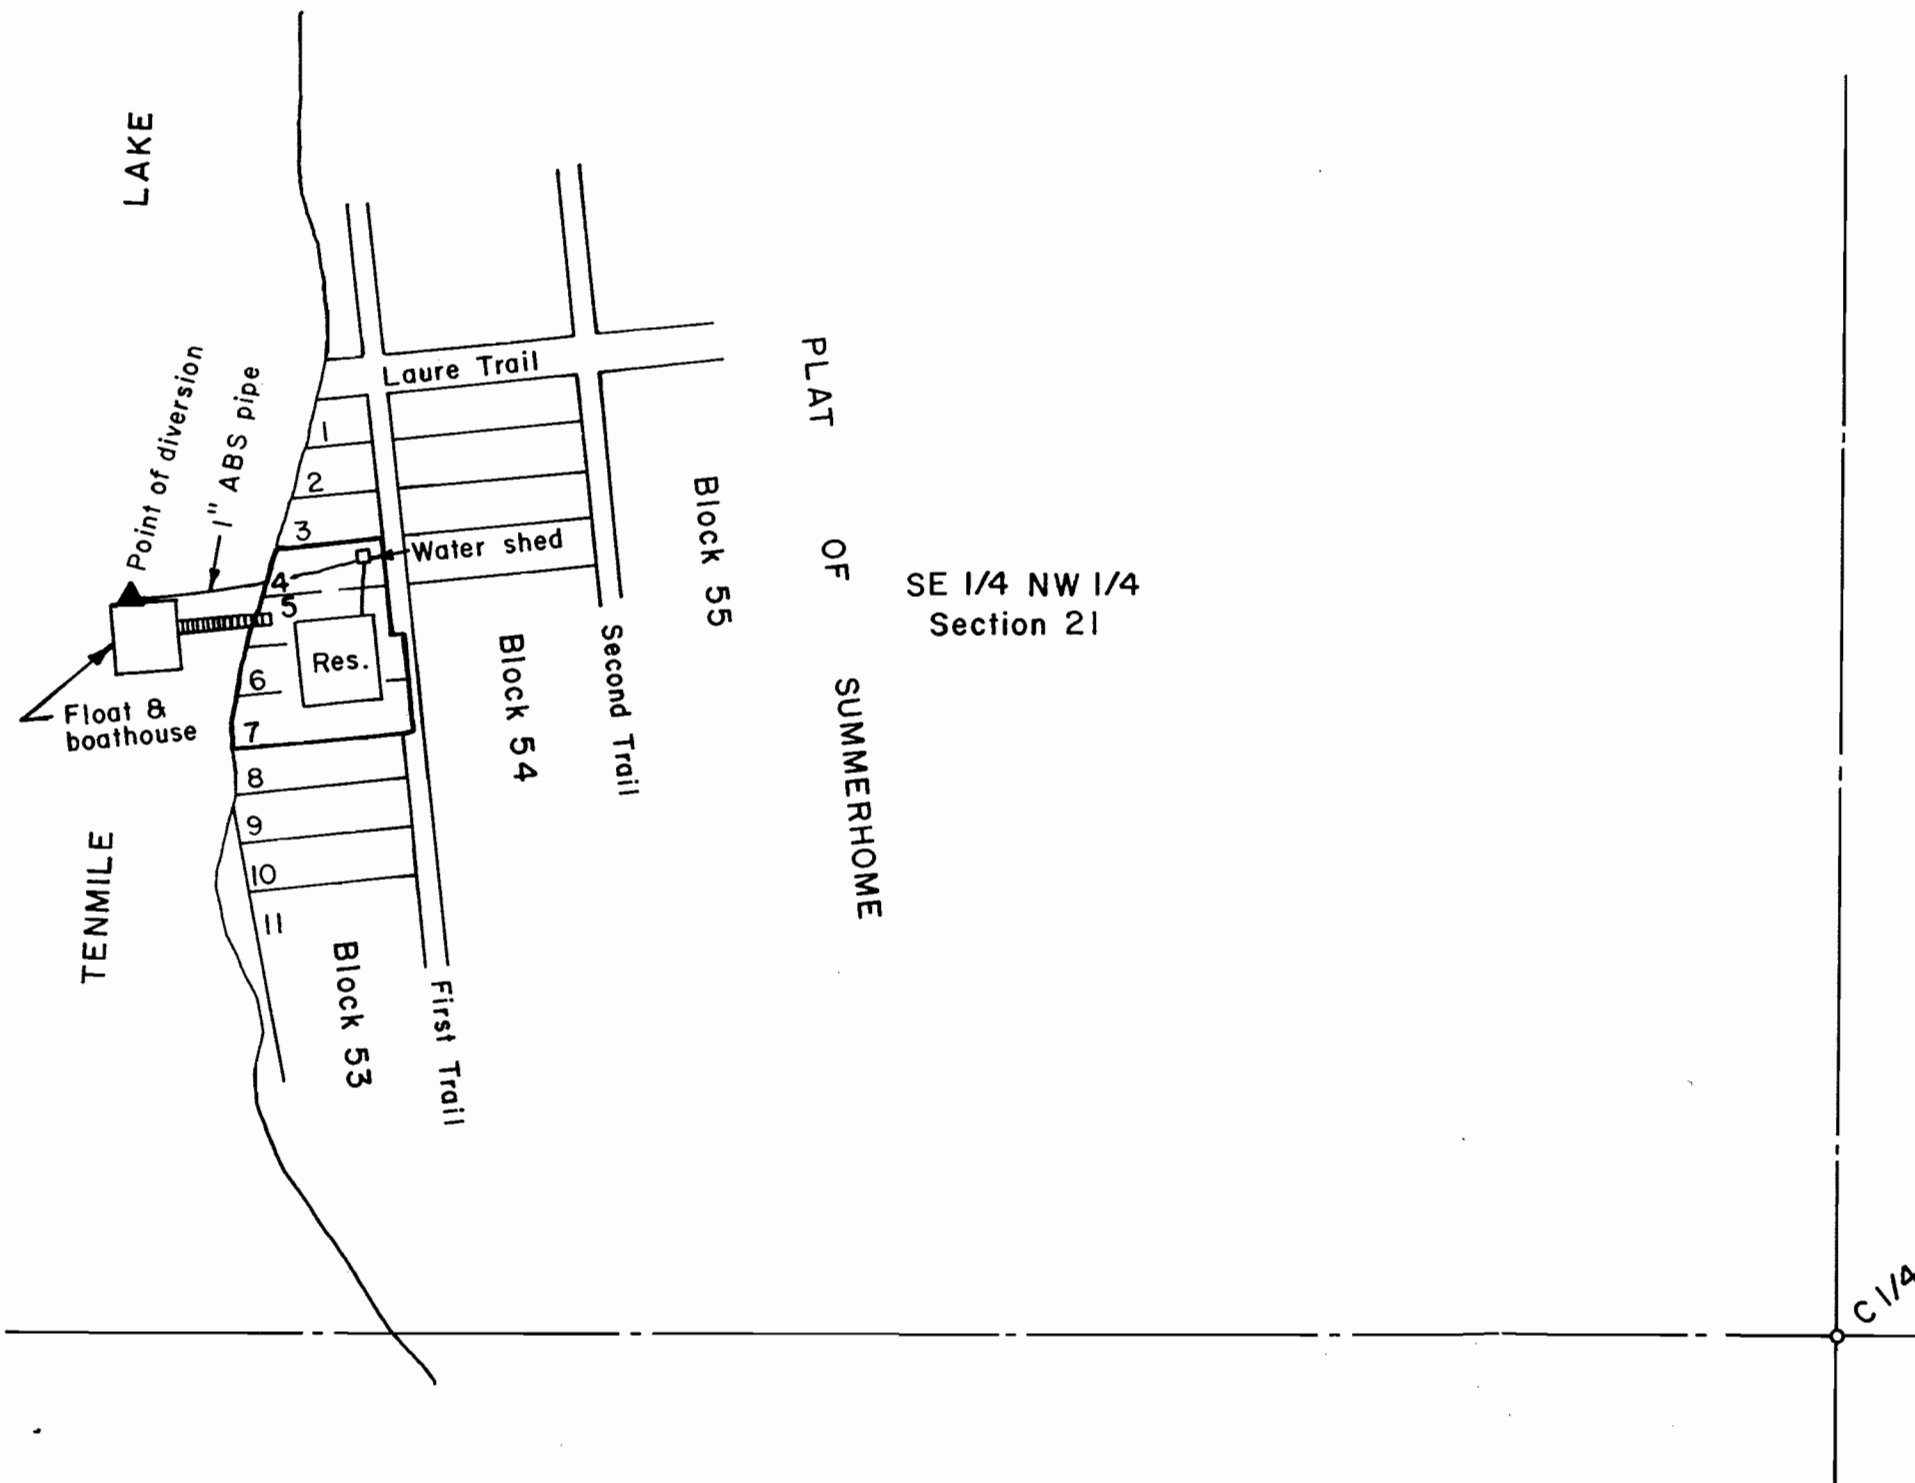

Scale: 1" = 100 ft.

Point of diversion is 380 ft. North
& 890 ft. West of the C 1/4 corner
of Section 21.


FINAL PROOF SURVEY OF A
PERMIT TO APPROPRIATE SURFACE WATER
IN LOTS 4, 5, 6 & 7, BLOCK 53, PLAT OF
SUMMERHOME ON TENMILE LAKE, IN THE
SE 1/4 NW 1/4 OF SECTION 21, T23S, R12W,
W.M., COOS COUNTY, OREGON

Application No. S-80980

Permit No. 53056

For: Elmer C. Thompson
185 W. Oriole
Roseburg, Oregon 97470

By: Shaner Engineering, Inc.
P.O. Box 1430
Roseburg, Oregon 97470

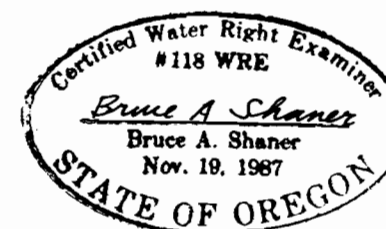

Renews June 30, 2000

August 26, 1998