


RECEIVED

SEP 01 1998
WATER RESOURCES DEPT.
SALEM, OREGON

Point of Diversion is 440 ft.
North & 30 ft. East of the
C 1/4 corner of Section 20:

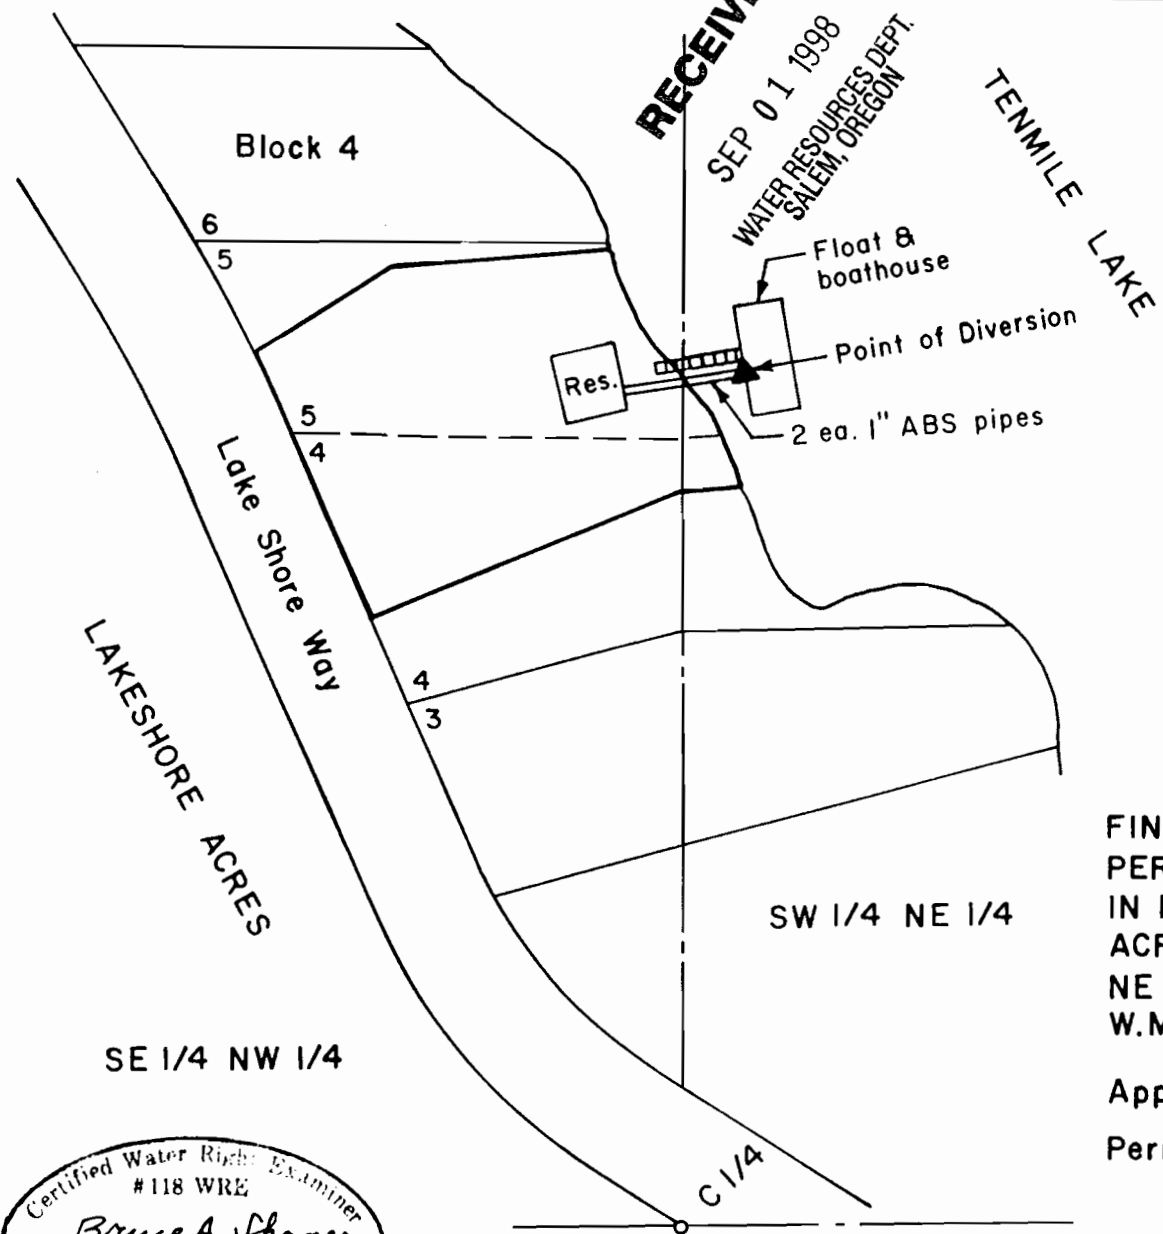

Scale: 1" = 100 ft.

FINAL PROOF SURVEY OF A
PERMIT TO APPROPRIATE SURFACE WATER
IN LOTS 4 & 5, BLOCK 4, LAKESHORE
ACRES IN THE SE 1/4 NW 1/4 & THE SW 1/4
NE 1/4 OF SECTION 20, T23S, R12W,
W.M., COOS COUNTY, OREGON

Application No. S-81009

Permit No. 53167

For: Henry M. Bailey
P.O. Box 1518
Roseburg, Oregon 97470

By: Shaner Engineering, Inc.
P.O. Box 1430
Roseburg, Oregon 97470

August 26, 1998



Renews June 30, 2000