

Tax Lot No. TL600 & TL700 23 12 8D

Section 8 Township 23S Range 12W W.M.
Coos County


RECEIVED

OCT 16 1999

WATER RESOURCES DEPT.
SALEM, OREGON

SE1/16

S1/16

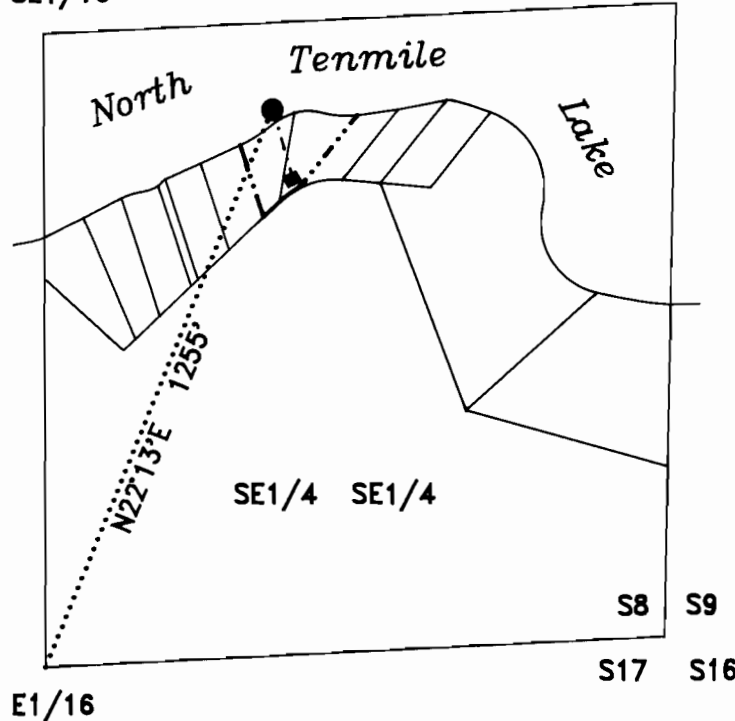


LEGEND

- HOME
- POINT OF DIVERSION
- WATERLINE
- PROPERTY LINE

EXAMINERS DISCLAIMER STATEMENT

The preparation of this map was for the purpose of identifying the location of the Water Right only and has no intent to provide dimensions or location of property ownership lines.

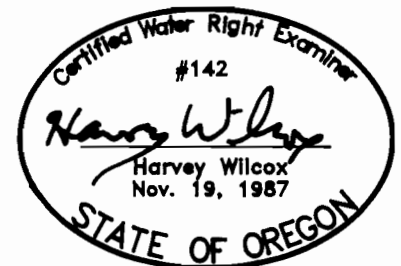

RENEWAL 6/30/00

FINAL PROOF SURVEY
IN THE NAME OF
Wayne A. & Billie J. Folger

Surveyed on 8/27/99 by H.A. Wilcox

Application No. S-81036
Permit No. 54008