


Tax Lot No. 23 12 17DC TL300
Section 17 Township 23S Range 12W W.M.
Coos County

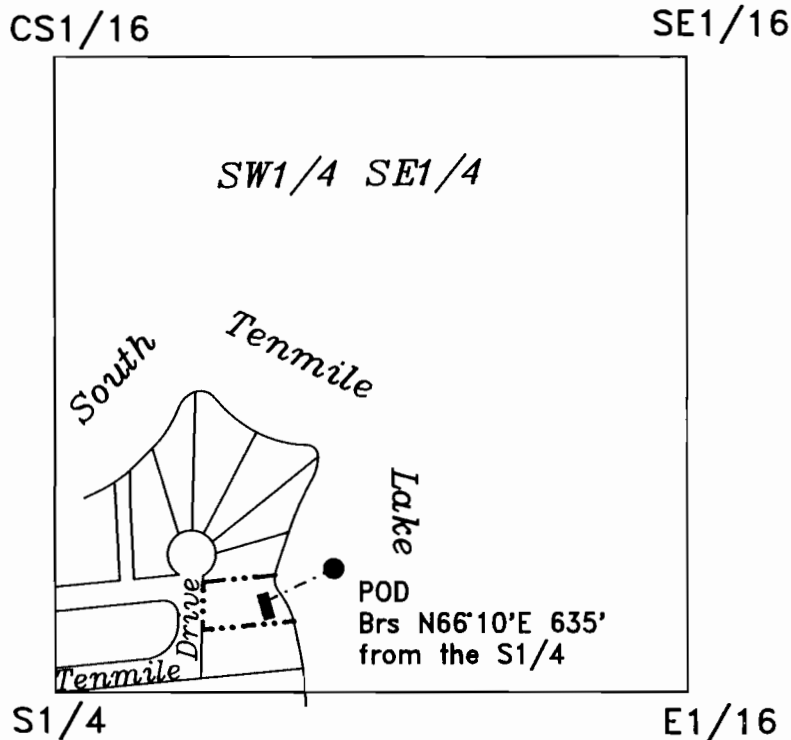

Legend

- P.O.D.
- - - - - Property Line
- - - - - Waterline
- House


RECEIVED

AUG 19 1997

WATER RESOURCES DEPT
SALEM, OREGON

EXAMINERS DISCLAIMER STATEMENT

The preparation of this map was for the purpose of identifying the location of the Water Right only and has no intent to provide dimensions or location of property ownership lines.

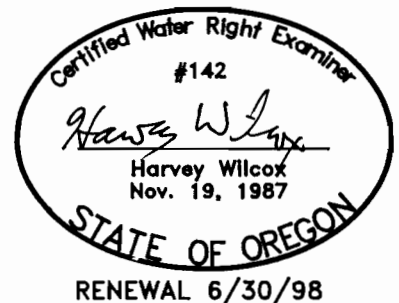

FINAL PROOF SURVEY
IN THE NAME OF
Richard and Nancy West

Surveyed on 7/13/97 by H.A. Wilcox

Application No. S-81037
Permit No. 53079