


Tax Lot TL100 23 12 20AB
Section 20 Township 23S Range 12W W.M.
Coos County

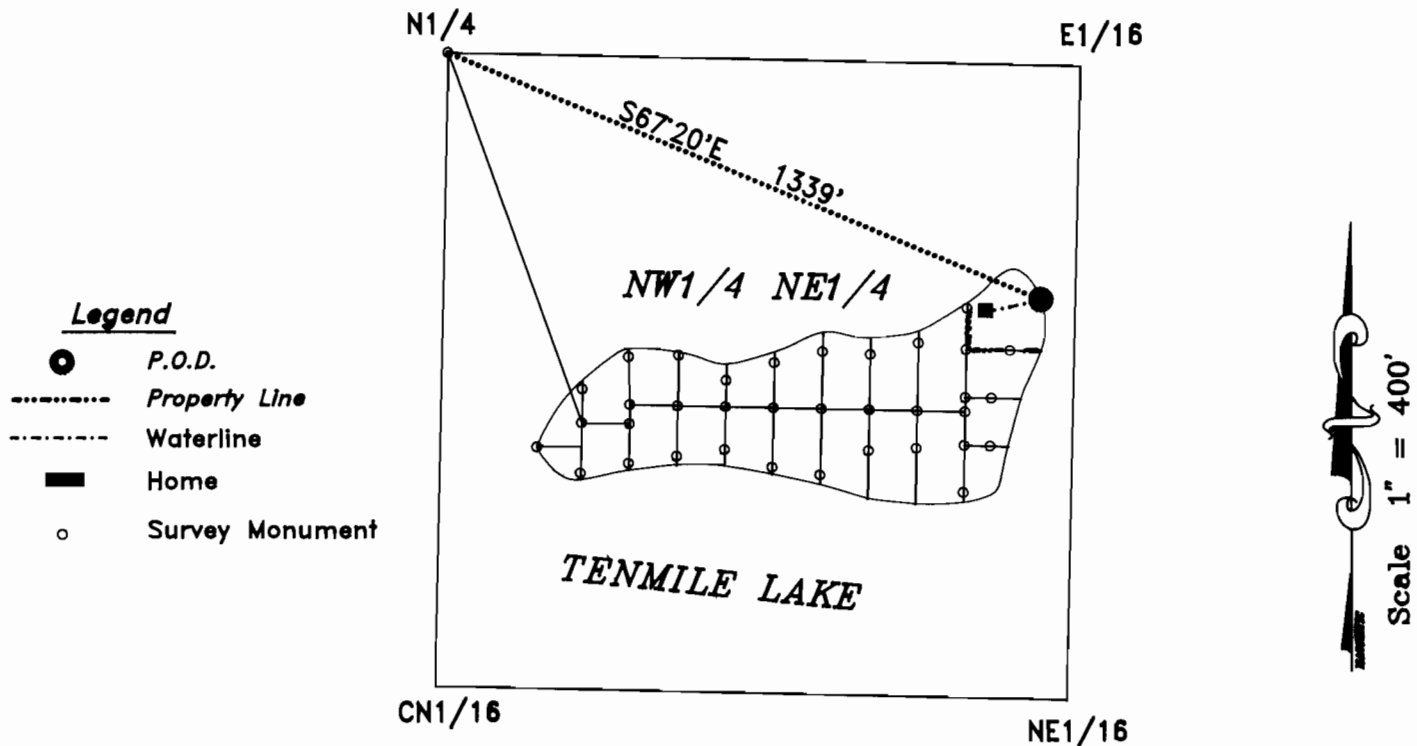


EXAMINERS DISCLAIMER STATEMENT

The preparation of this map was for the purpose of identifying the location of the Water Right only and has no intent to provide dimensions or location of property ownership lines.

FINAL PROOF SURVEY
IN THE NAME OF
Mary Alice Gray

Surveyed on 7/30/97 by H.A. Wilcox

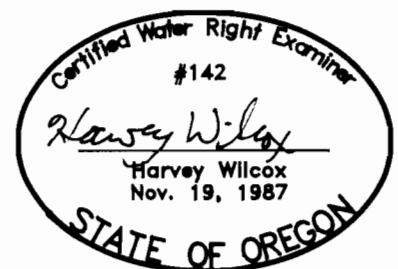

RENEWAL 6/30/98

Application No. S-81126
Permit No. 54002