


Tax Lot No. TL500 23 12 20BC
 Section 20 Township 23S Range 12W W.M.
 Coos County

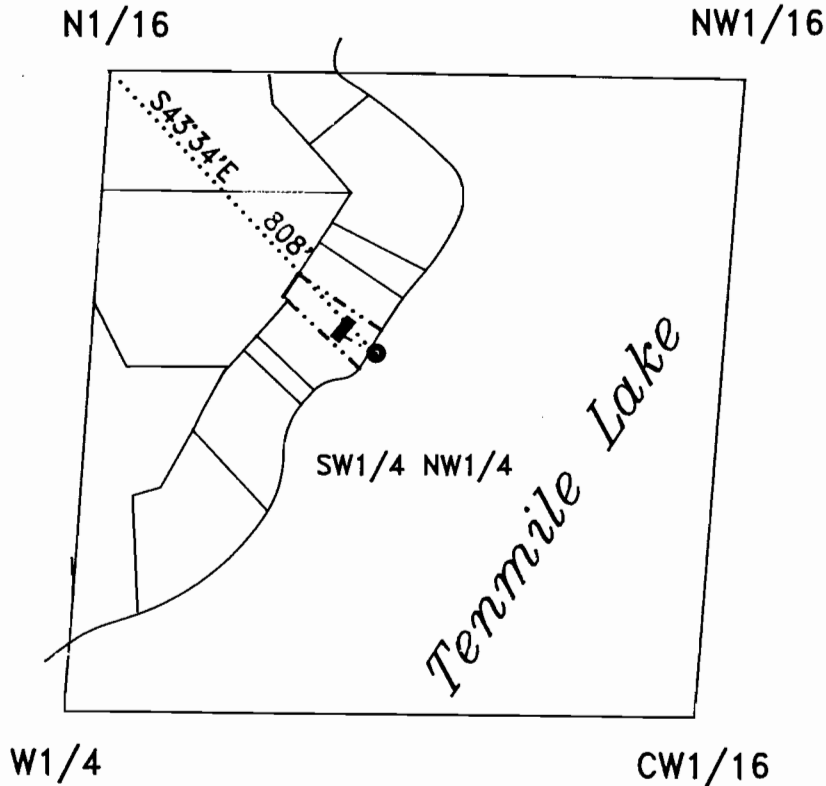

Scale 1" = 400'


Legend

- P.O.D.
- - - - - Property Line
- - - - - Waterline
- House

NOV 27 1998
 LAND SURVEY DEPT.
 OREGON

EXAMINERS DISCLAIMER STATEMENT

The preparation of this map was for the purpose of identifying the location of the Water Right only and has no intent to provide dimensions or location of property ownership lines.

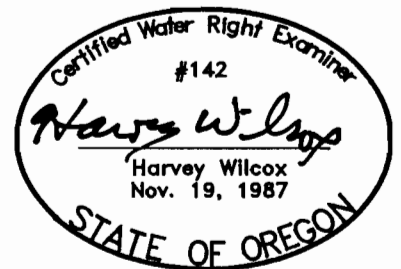

RENEWAL 6/30/00

FINAL PROOF SURVEY

IN THE NAME OF

Jim and Lois Munson

Surveyed on 5/30/98 by H.A. Wilcox

Application No. S-81127
 Permit No. 53093