


Tax Lot No. TL300 23 12 20CC
Section 20 Township 23 Range 12 W.M.
Coos County

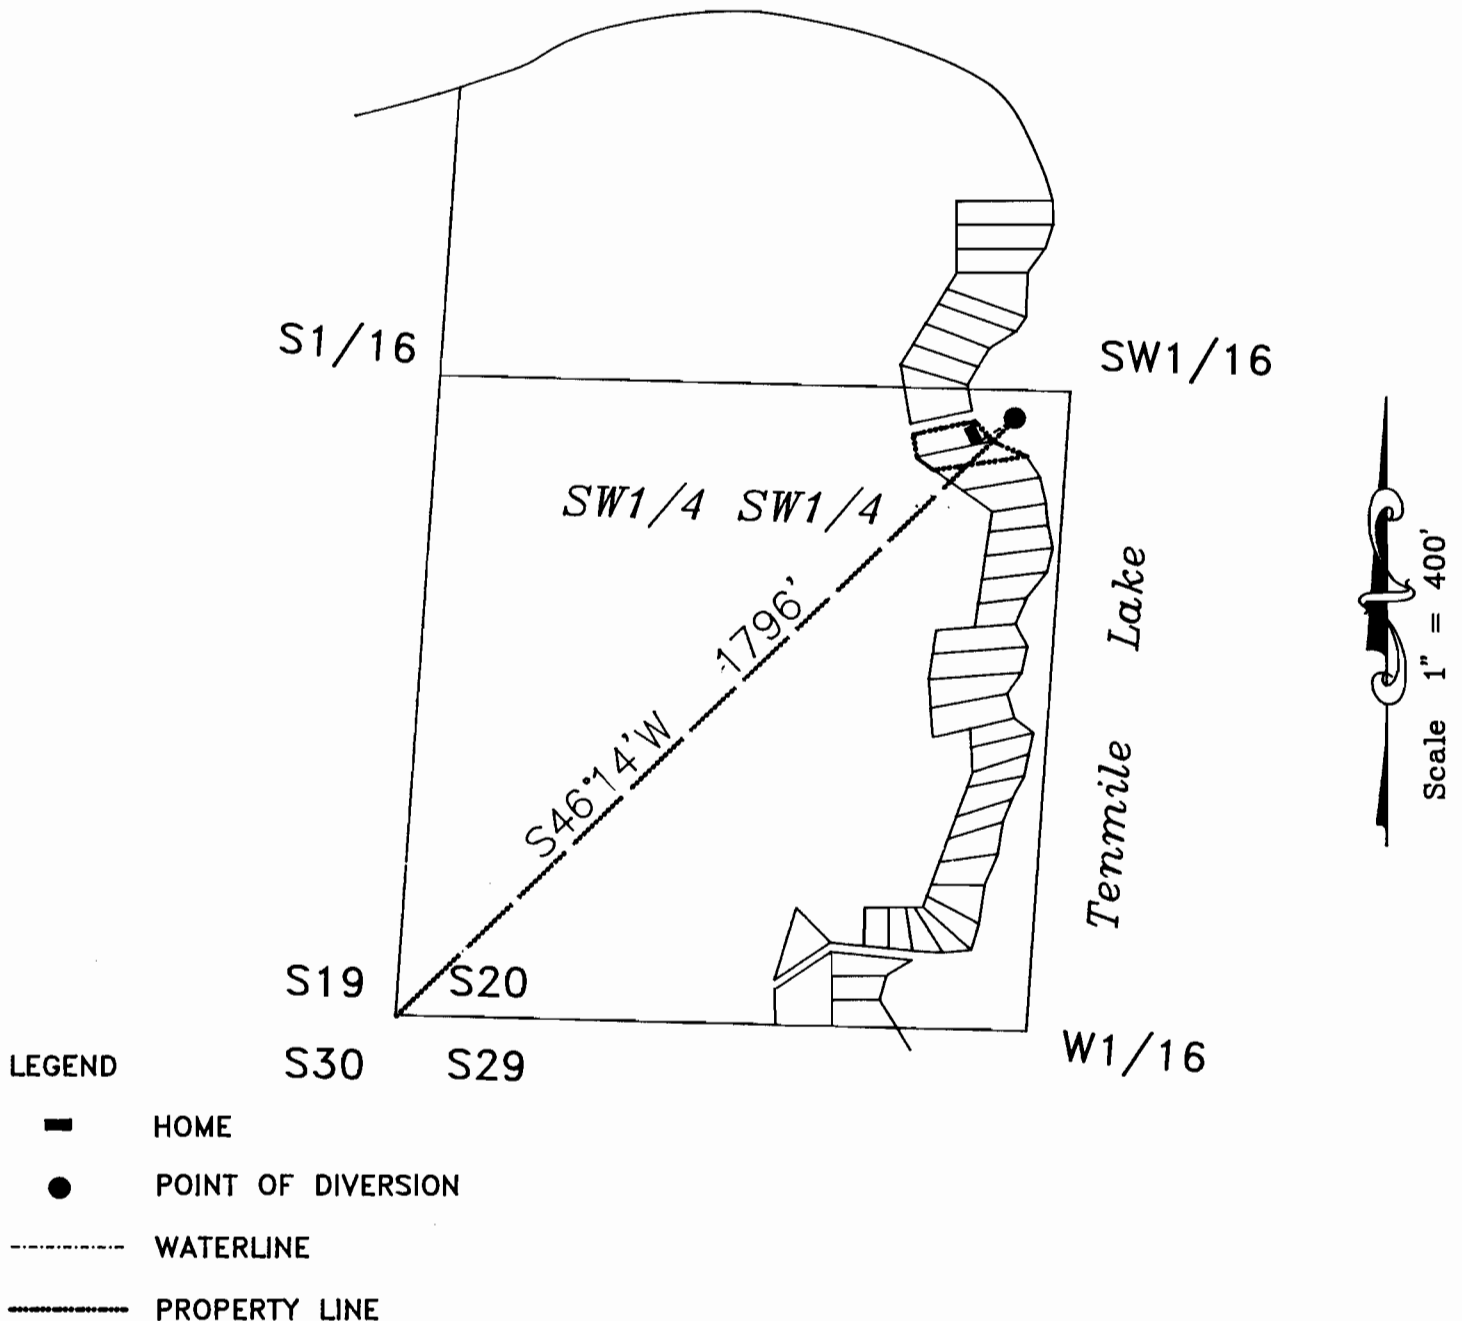


EXAMINERS DISCLAIMER STATEMENT

The preparation of this map was for the purpose of identifying the location of the Water Right only and has no intent to provide dimensions or location of property ownership lines.

RECEIVED

OCT 17 2000

WATER RESOURCES DEPT.
SALEM, OREGON

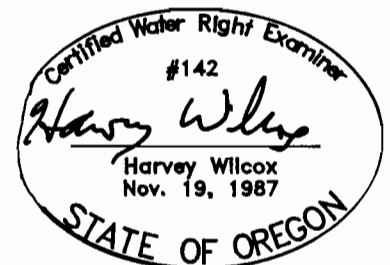

RENEWAL 6/30/02

FINAL PROOF SURVEY
IN THE NAME OF
Douglas S. Gohman

Surveyed on 9/18/00 by H.A. Wilcox

Application No. S-81162
Permit No. 53100