


Tax Lot No. TL 700

Section 28 Township 23S Range 12W W.M.  
Coos County

RECEIVED

SEP 08 1999

WATER RESOURCES DEPT  
SALEM, OREGON

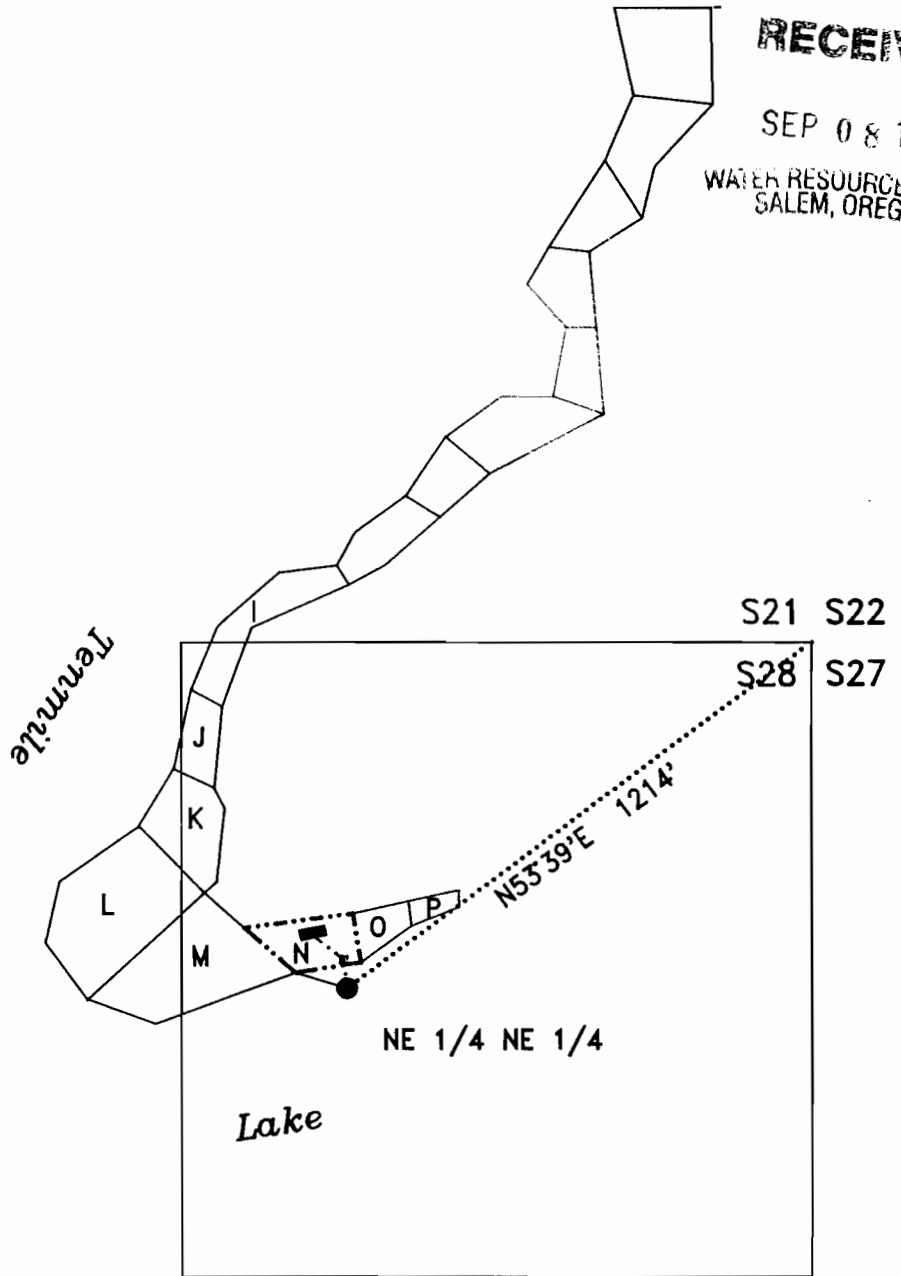


LEGEND

- HOME
- POINT OF DIVERSION
- WATERLINE
- PROPERTY LINE
- PUMP HOUSE

EXAMINERS DISCLAIMER STATEMENT

The preparation of this map was for the purpose of identifying the location of the Water Right only and has no intent to provide dimensions or location of property ownership lines.

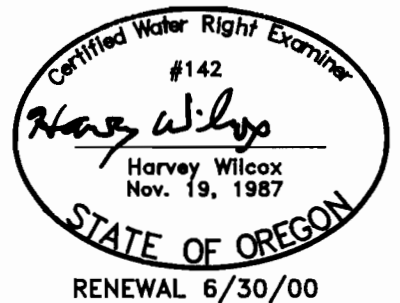

**FINAL PROOF SURVEY**  
IN THE NAME OF  
**BETTY REEVES**

Surveyed on 7/14/99 by H.A. Wilcox

Application No. S-81187  
Permit No. 53156