


Tax Lot No. TL1000 & TL1100 23 12 8D
Section 8 Township 23S Range 12W W.M.
Coos County

Scale 1" = 400'

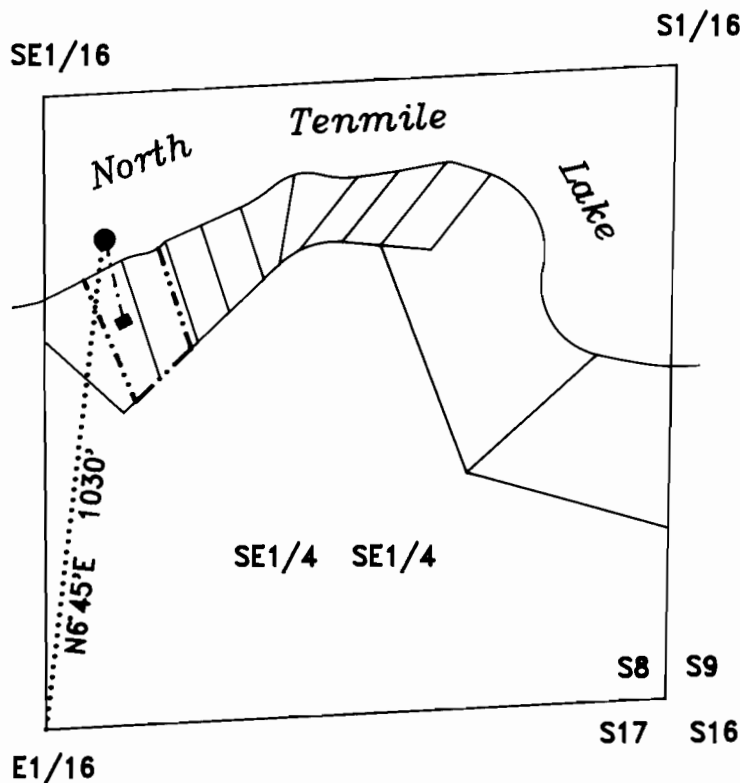

RECEIVED

OCT 05 1999

WATER RESOURCES DEPT.
SALEM, OREGON

LEGEND


- HOME
- POINT OF DIVERSION
- WATERLINE
- PROPERTY LINE

EXAMINERS DISCLAIMER STATEMENT

The preparation of this map was for the purpose of identifying the location of the Water Right only and has no intent to provide dimensions or location of property ownership lines.

FINAL PROOF SURVEY
IN THE NAME OF
Elmer & Darlene Young

Surveyed on 8/27/99 by H.A. Wilcox

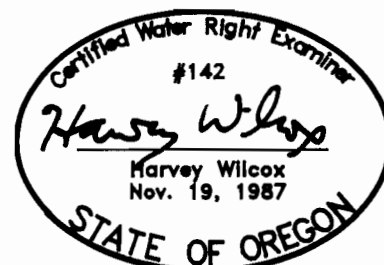

RENEWAL 6/30/00

Application No. S-81202
Permit No. 53188