


Tax Lot No. TL1700, TL1900 and TL2000 23 12 5AA
Section 5 Township 23S Range 12W W.M.
Coos County

RECEIVED

SEP 30 1997

WATER RESOURCES DEPT
SALEM, OREGON

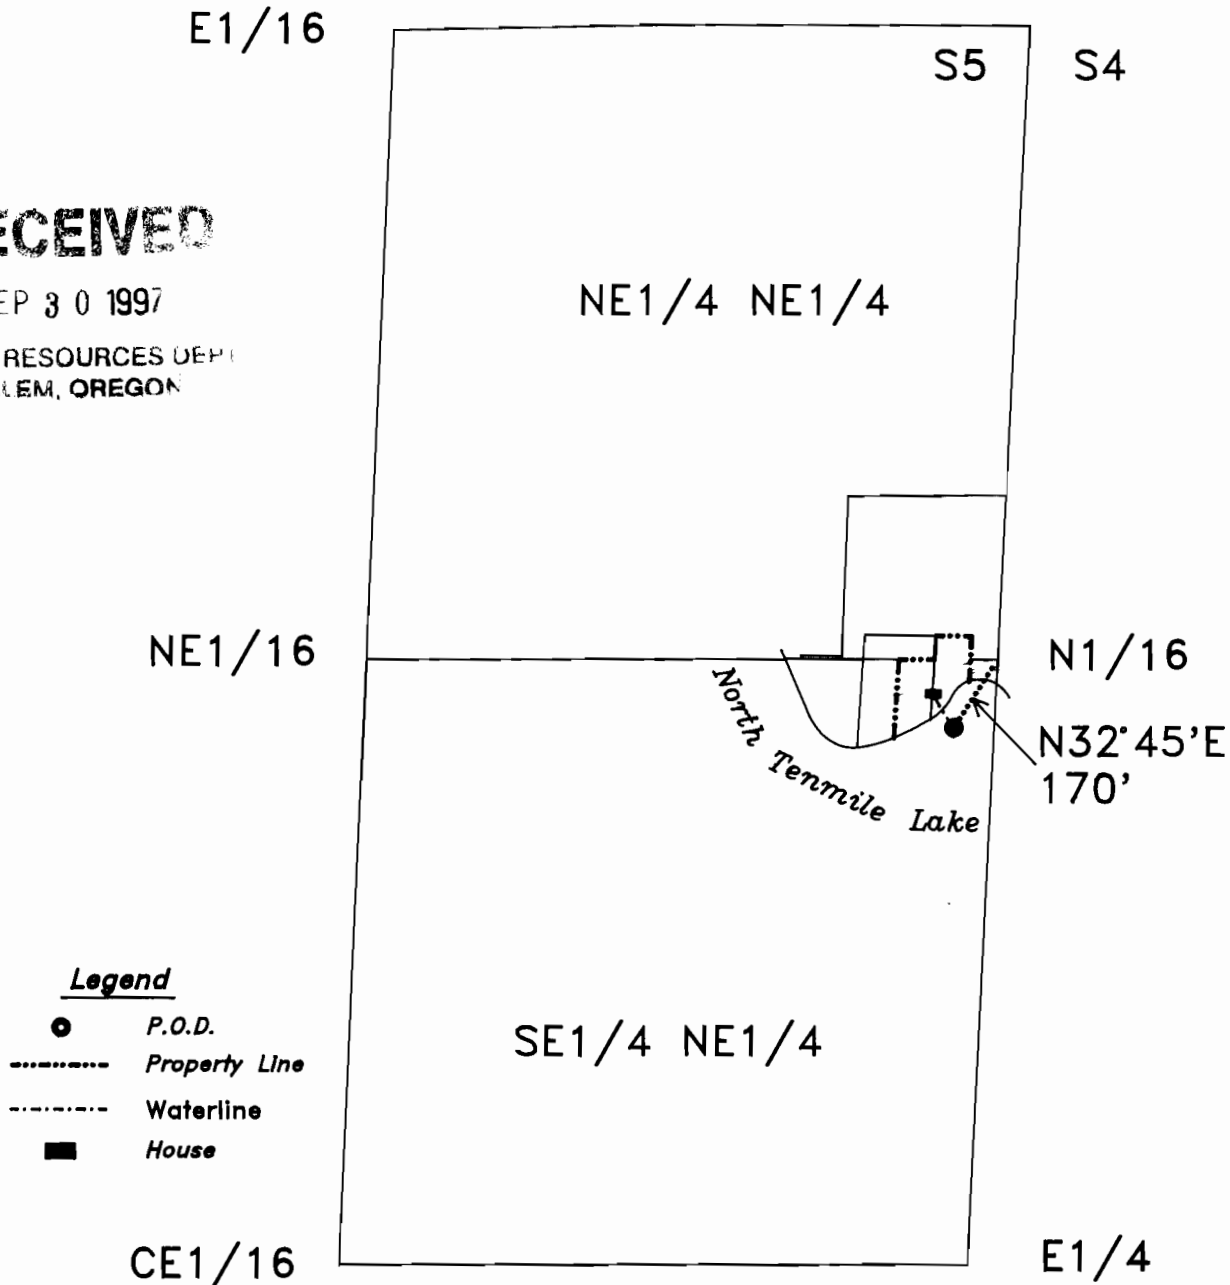

Legend

- P.O.D.
- Property Line
- Waterline
- House


EXAMINERS DISCLAIMER STATEMENT

The preparation of this map was for the purpose of identifying the location of the Water Right only and has no intent to provide dimensions or location of property ownership lines.

FINAL PROOF SURVEY
IN THE NAME OF

Donald J. Mercer and Bruce E. Dwight

Surveyed on 7/30/97 by H.A. Wilcox

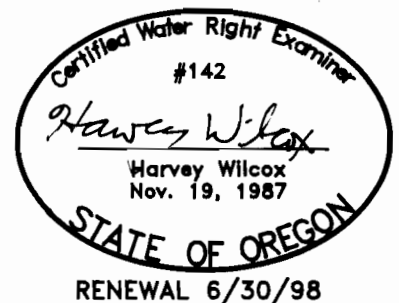

Application No. S-81207
Permit No. 53181