
Section 9 Township 23S Range 12W W.M.

Coos County

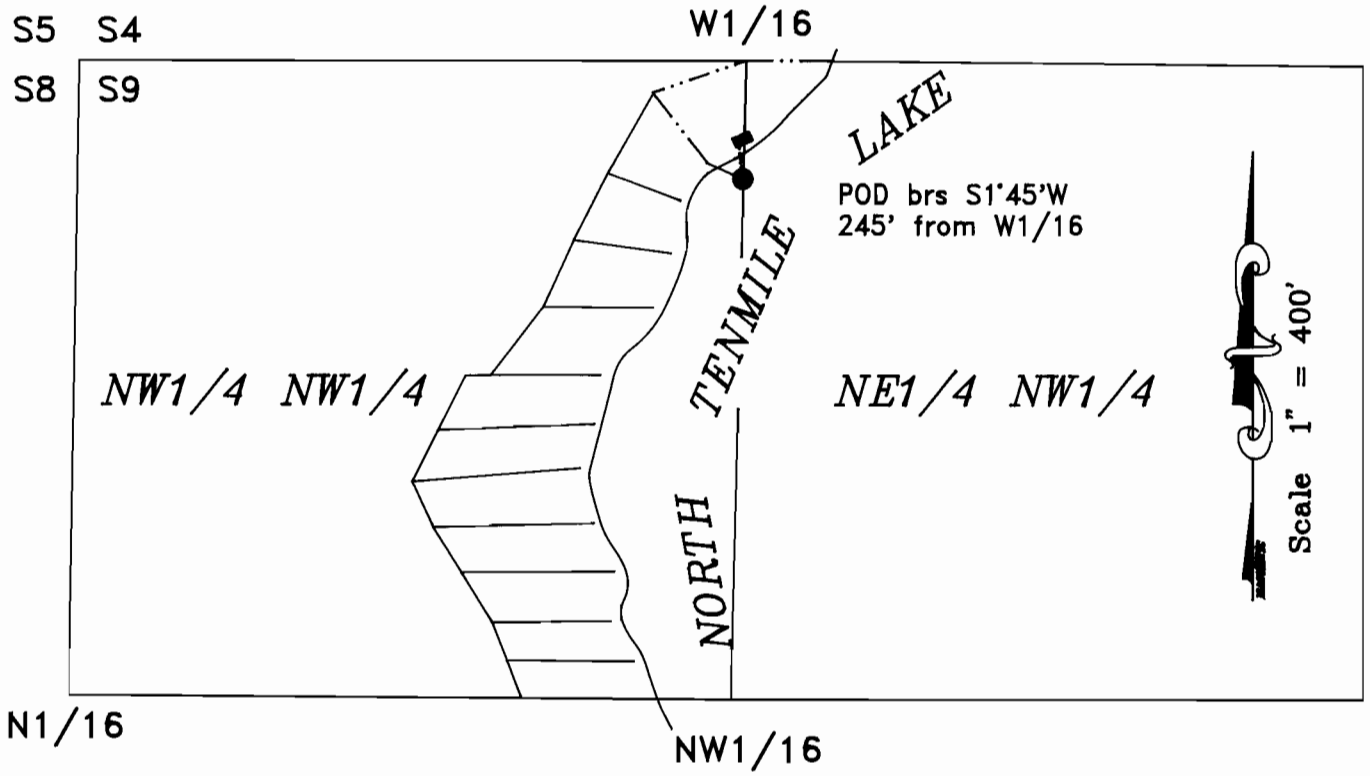

1997

Legend

- P.O.D.
- House
- Property Line
- Waterline

EXAMINERS DISCLAIMER STATEMENT

The preparation of this map was for the purpose of identifying the location of the Water Right only and has no intent to provide dimensions or location of property ownership lines.

Certified Water Right Examiner
#142
Harvey Wilcox
Nov. 19, 1987
STATE OF OREGON

RENEWAL 6/30/98

FINAL PROOF SURVEY

IN THE NAME OF

Clinton & Barbara Glad

Surveyed on 10/26/96 by H.A. Wilcox

Application No. S-81216

Permit No. 53126 DSP 10-11-01