

RECEIVED

MAR 6 2000

WATER RESOURCES DEPT
SALEM, OREGON

**CLAIM OF BENEFICIAL USE
FINAL PROOF MAP**

Located in the NW¼ SW¼ of Section 20
Township 23 South, Range 12 West, W.M.
Coos County, Oregon

Application S-81290

Permit 53199

Scale 1" = 100 Feet
Assessors Scale

Prepared For: Becky Nurge
Prepared By: Dennis Goude
Date Prepared: February 18, 2000

NW ¼ SW ¼
SECTION 20


NOTE:

The P.O.D. is an intake 3/4 HP submersible pump. The P.O.D. is located 1364 feet North and 1258 feet East from the Southwest corner of Section 20.

SHUTTERS

HEIGHTS

SUBDIVISION

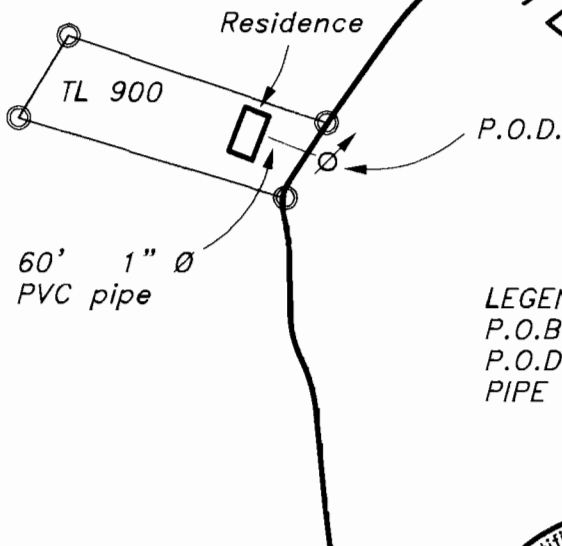

LEGEND

P.O.B.

P.O.D.

PIPE



EXPIRES 06/30/2001

EXAMINERS DISCLAIMER STATEMENT

The preparation of this map was for the purpose of identifying the location of the Water Right only and has no intent to provide dimensions or location of property ownership lines.

**Stuntzner Engineering
& Forestry, L.L.C.**

ENGINEERING • LAND SURVEYING • FORESTRY
PLANNING • WATER RIGHTS

705 South 4th St.
Post Office Box 118
Coos Bay, Oregon 97420

Phone: (541) 267-2872
Fax: (541) 267-0588