


Tax Lot No. 23 12 29BD TL200 & 23 12 29 BA TL400

Section 29 Township 23S Range 12W W.M.  
Coos County

**RECEIVED**

JUN 25 1997

WATER RESOURCES DEP  
SALEM, OREGON

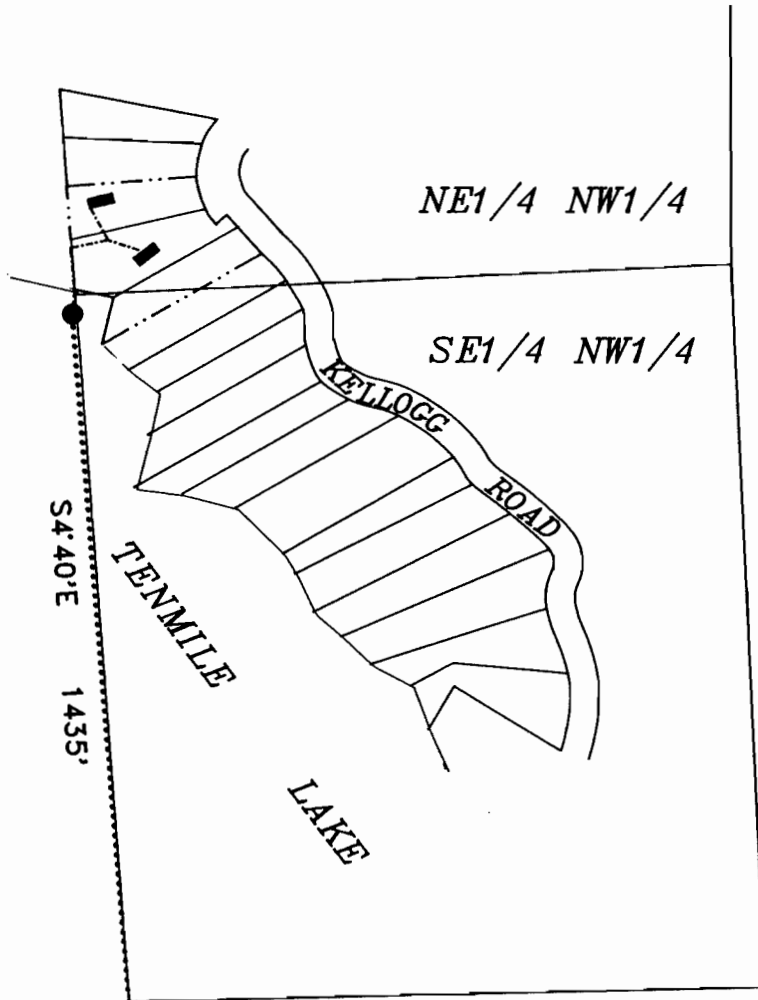

CN1/16

**LEGEND**

- HOME
- POINT OF DIVERSION
- WATERLINE
- PROPERTY LINE

CW1/16

C1/4


**EXAMINERS DISCLAIMER STATEMENT**

The preparation of this map was for the purpose of identifying the location of the Water Right only and has no intent to provide dimensions or location of property ownership lines.

**FINAL PROOF SURVEY**

IN THE NAME OF

Paul A. and Mary A. Murphy

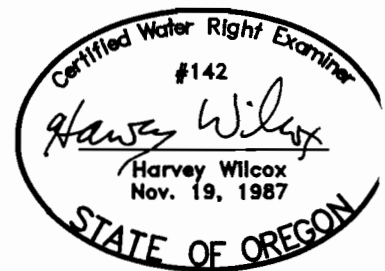

RENEWAL 6/30/98

Surveyed on 6/3/97 by H.A. Wilcox

Application No. S-81355  
Permit No. 53131