


Point of Diversion is 570 ft.
North 8 40 ft. West of the
C 1/4 corner of Section 20.

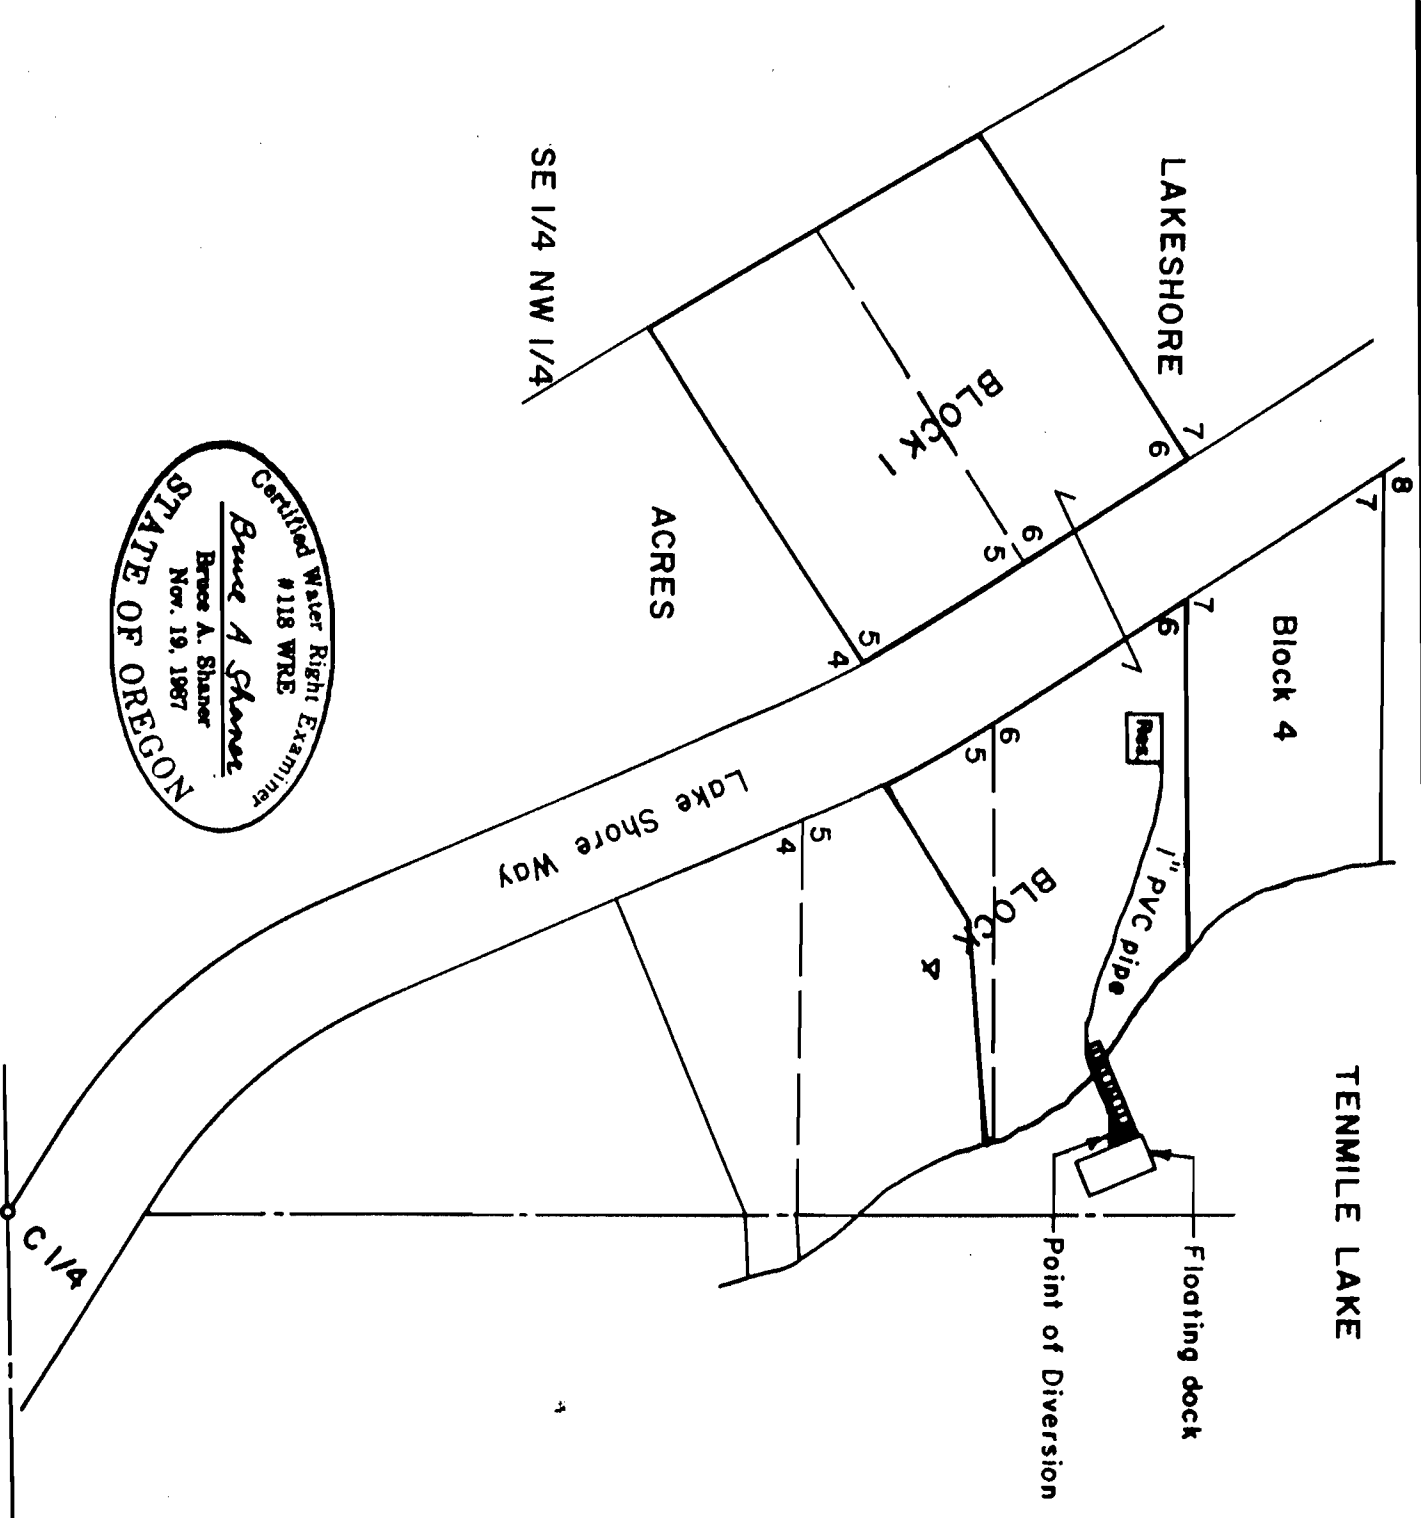

Scale: 1" = 100 ft.



FINAL PROOF SURVEY OF A
PERMIT TO APPROPRIATE SURFACE WATER
IN LOTS 5 & 6, BLOCK 4, & LOTS 5 & 6,
BLOCK 1, LAKESHORE ACRES IN THE SE 1/4
NW 1/4 OF SECTION 20, T23S, R12W, W.M.,
COOS COUNTY, OREGON

Application No. S-81446

Permit No. 53133

For: Ralph & Joann Sandstede
135 W Berdine St.
Roseburg, Oregon 97470
By: Shaner Engineering, Inc.
P.O. Box 1430
Roseburg, Oregon 97470

WATER RESOURCES DEPT.
SALEM, OREGON

RECEIVED

AUG 05 1998

July 31, 1998

Certified Water Right Examiner
#118 WRE
Bruce A. Shaner
Bruce A. Shaner
Nov. 19, 1987
STATE OF OREGON