

Tax Lot No. TL2300 23 12 22B
Section 22 Township 23S Range 12W W.M.
Coos County

S16 S15
S21 S22


LEGEND

- HOME
- POINT OF DIVERSION
- WATERLINE
- PROPERTY LINE

EXAMINERS DISCLAIMER STATEMENT

The preparation of this map was for the purpose of identifying the location of the Water Right only and has no intent to provide dimensions or location of property ownership lines.

Scale 1" = 400'

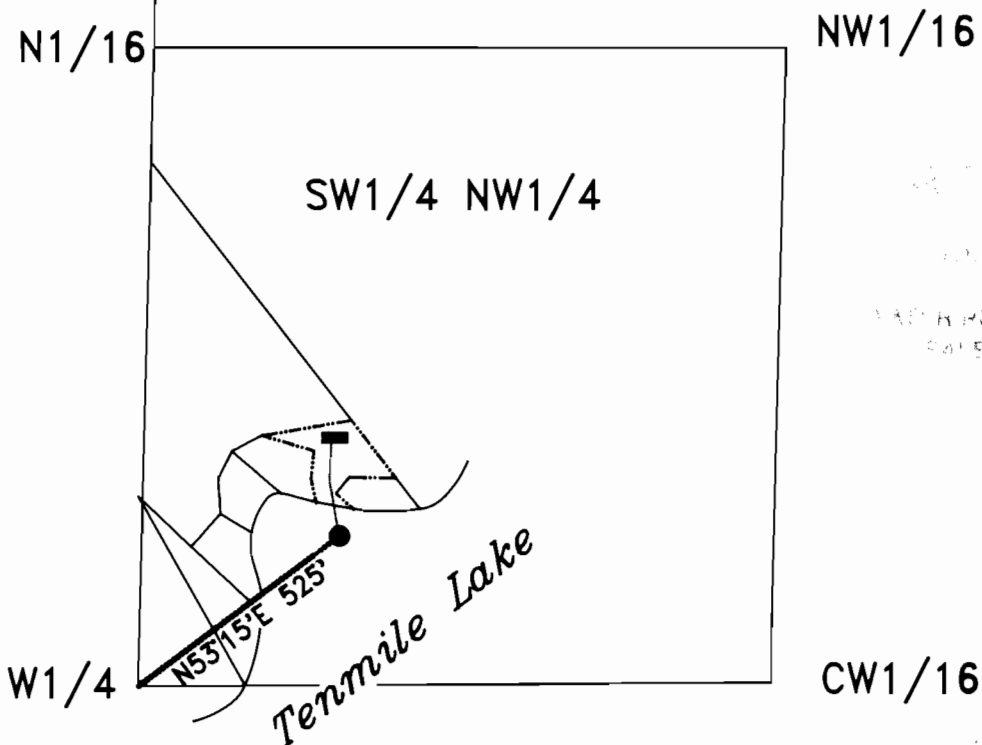

4/23/98

Harvey Wilcox


WATER RIGHTS EXAMINER
STATE OF OREGON

FINAL PROOF SURVEY

IN THE NAME OF

Gene, Teresa and Phillip Moritz

Surveyed on 4/23/98 by H.A. Wilcox

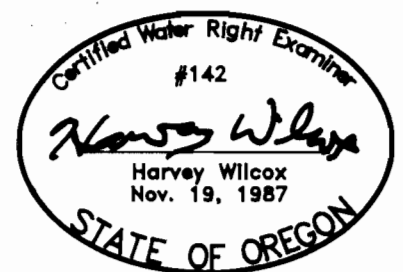

RENEWAL 6/30/98

Application No. S-81459
Permit No. 53220