G-8575
56699
T 8926
79304

T.26S. R.14E. W.M.

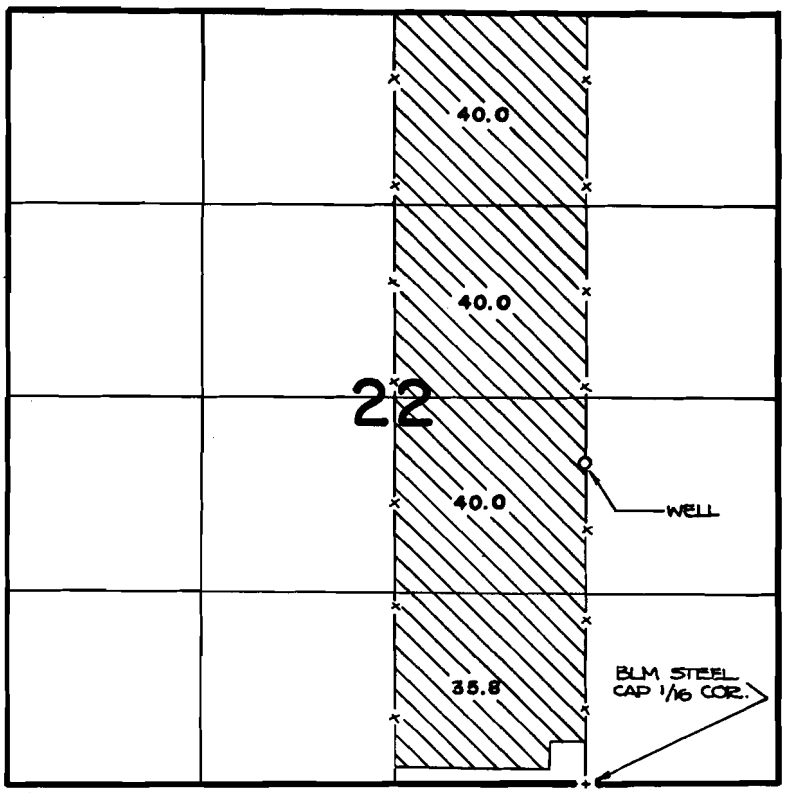

THE WELL IS LOCATED 2210 FT. N. AND 20 FT. W. FROM THE S.E. CORNER OF THE SW 1/4 SE 1/4.

N

SCALE: 4" = 1 MILE

FINAL PROOF SURVEY
UNDER

Application No. G-9262 Permit No. G-8575
IN NAME OF

FRED R. AND MARYANN LYNCH

Surveyed OCT. 13, 19 84, by P. Pagten

PRP PTS 11/27/84