


T. 27 S., R. 3 W., W. M.

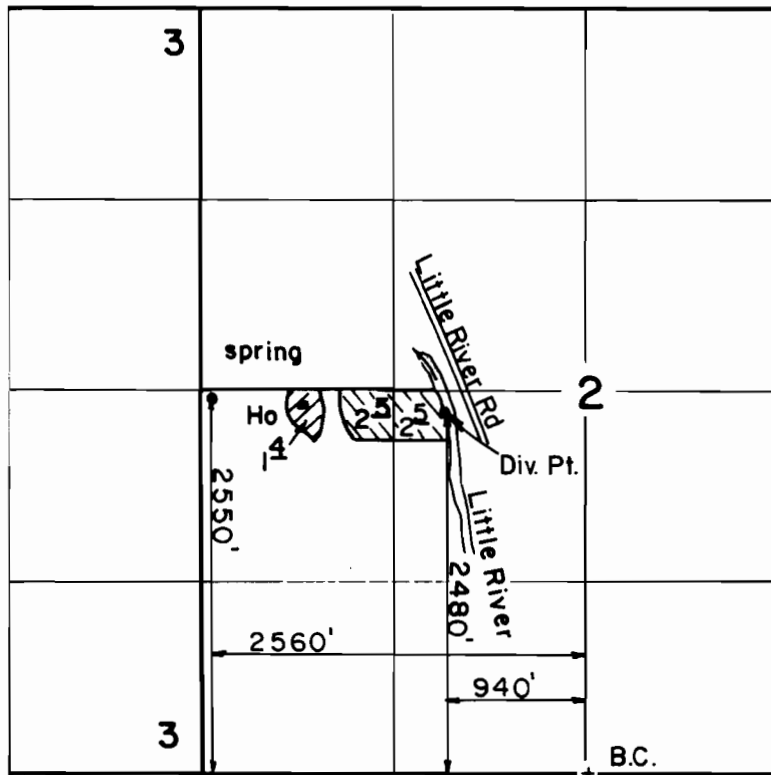

Scale: 1" = 1320'

**FINAL PROOF SURVEY
UNDER**

Application No. 50001 Permit No. 379.47....
IN NAME OF

.....
Surveyed AUG. 27. 1991., by B.S. JAMES..