


T. 23 S., R. 10 W., W. M.

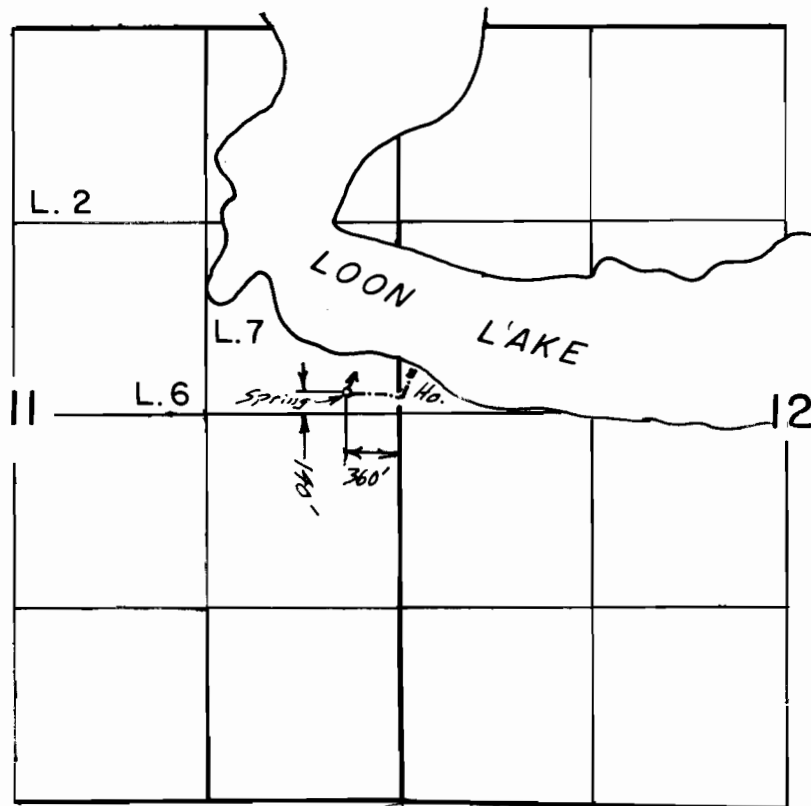

Scale 1" = 1320'

FINAL PROOF SURVEY
UNDER

Application No. 54736 Permit No. 41059
IN NAME OF

Loyel W. & Sharon C. Arrant

Surveyed Aug. 27, 1996., by S. DeHAAS