State ...

Pt Sec 36

Twp 20 SR 10 ... M.

SEC

THIS MAP WAS PREPARED FOR ASSESSMENT PURPOSE ONLY.
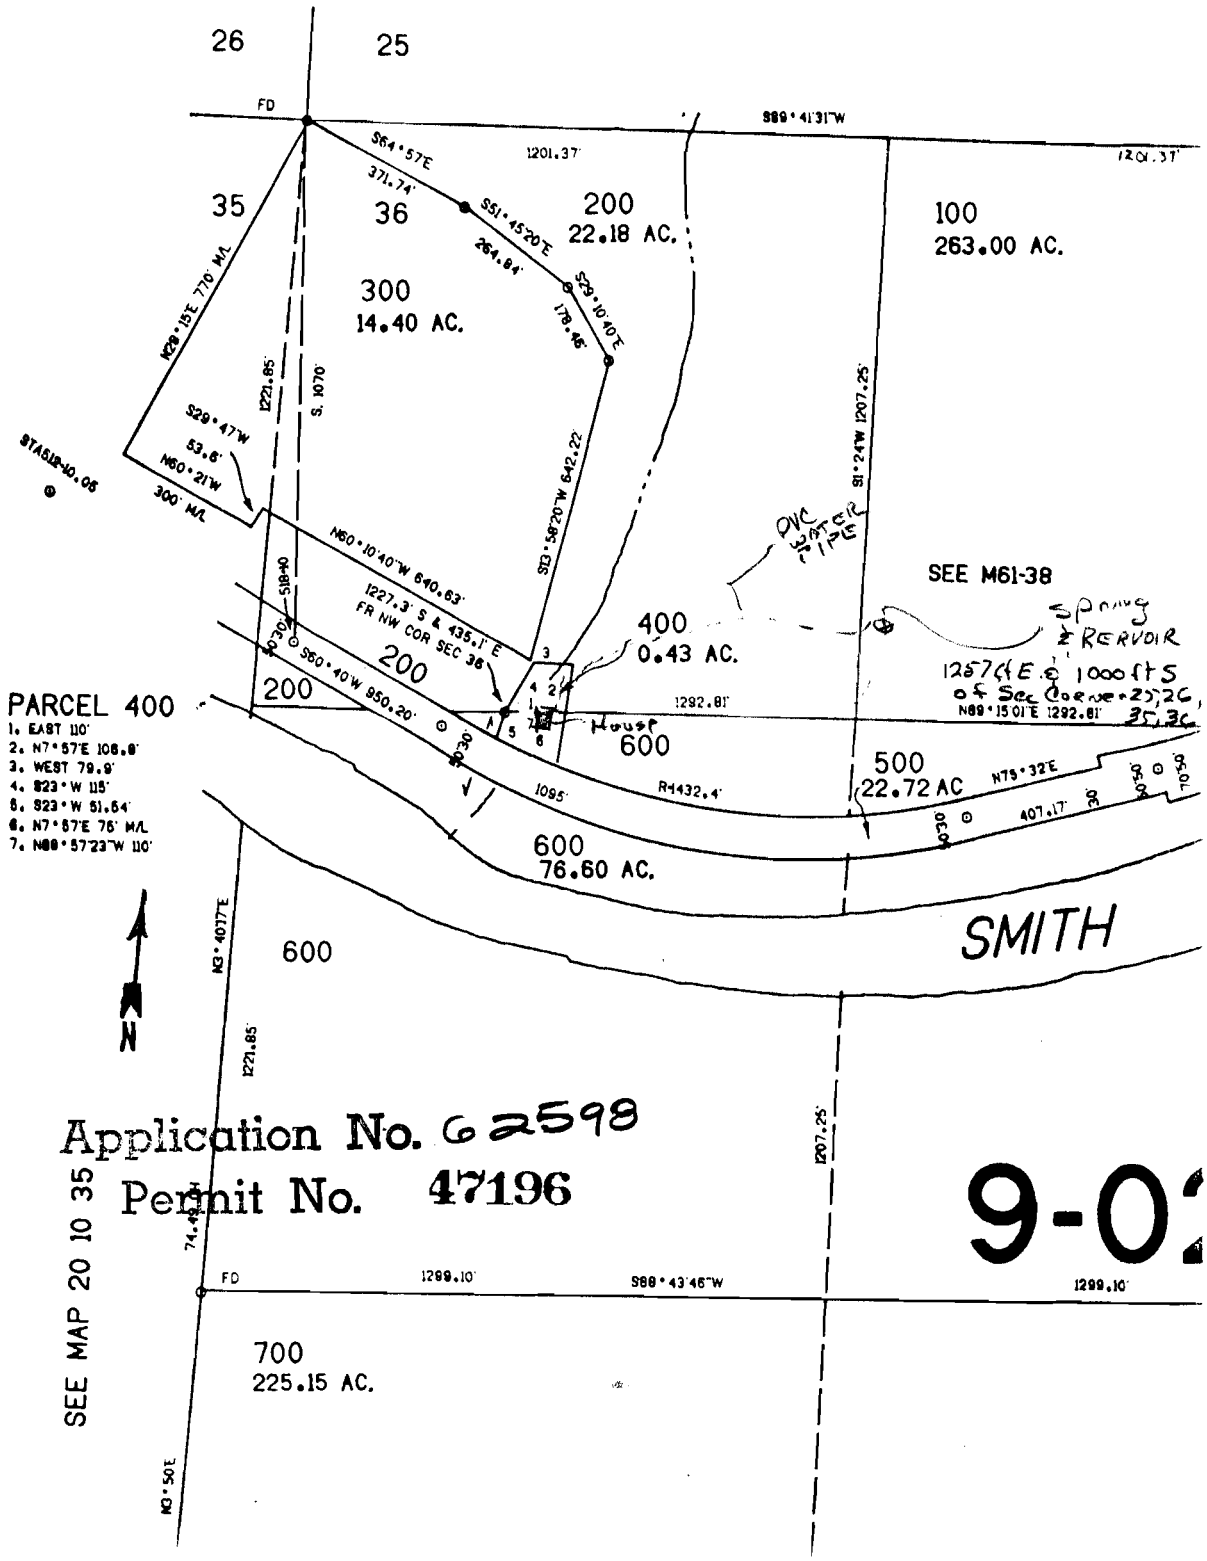
RECEIVED
OCT 22 1982
WATER RESOURCES DEPT.
SALEM, OREGON