


T. 20 S., R. 6 W., W.M.

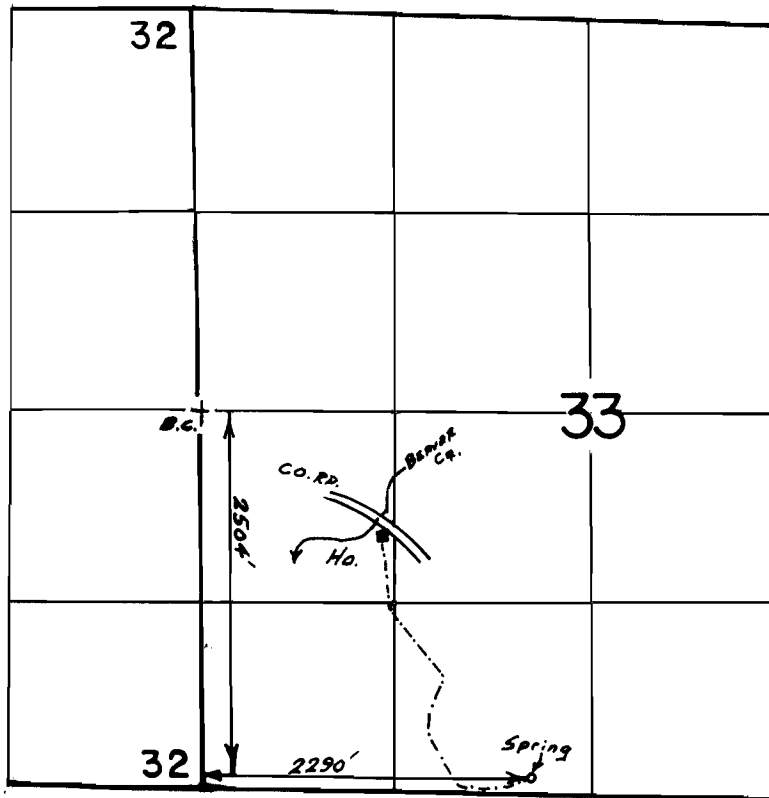

Scale 1" = 1320'

**FINAL PROOF SURVEY**  
**UNDER**

Application No. 68844 Permit No. 50003....  
IN NAME OF

.....SCOTT & MARY STEFANSEN

Surveyed April 10, 1996., by S. DeHaas.....  
July 21, 1995