

T 25 S, R 6 W, WM
SECTION 24

FINAL PROOF SURVEY



SCALE 1" = 400 FEET
NOV. 12, 1992



PERMIT NO. 50715

PERMITEE:

TRACY WARD
632 SCHUDISKE ROAD
SURTHERLIN, OREGON 97479

CWRE:

JAMES ARTMAN
P.O. BOX 576
WINSTON, OREGON 97496

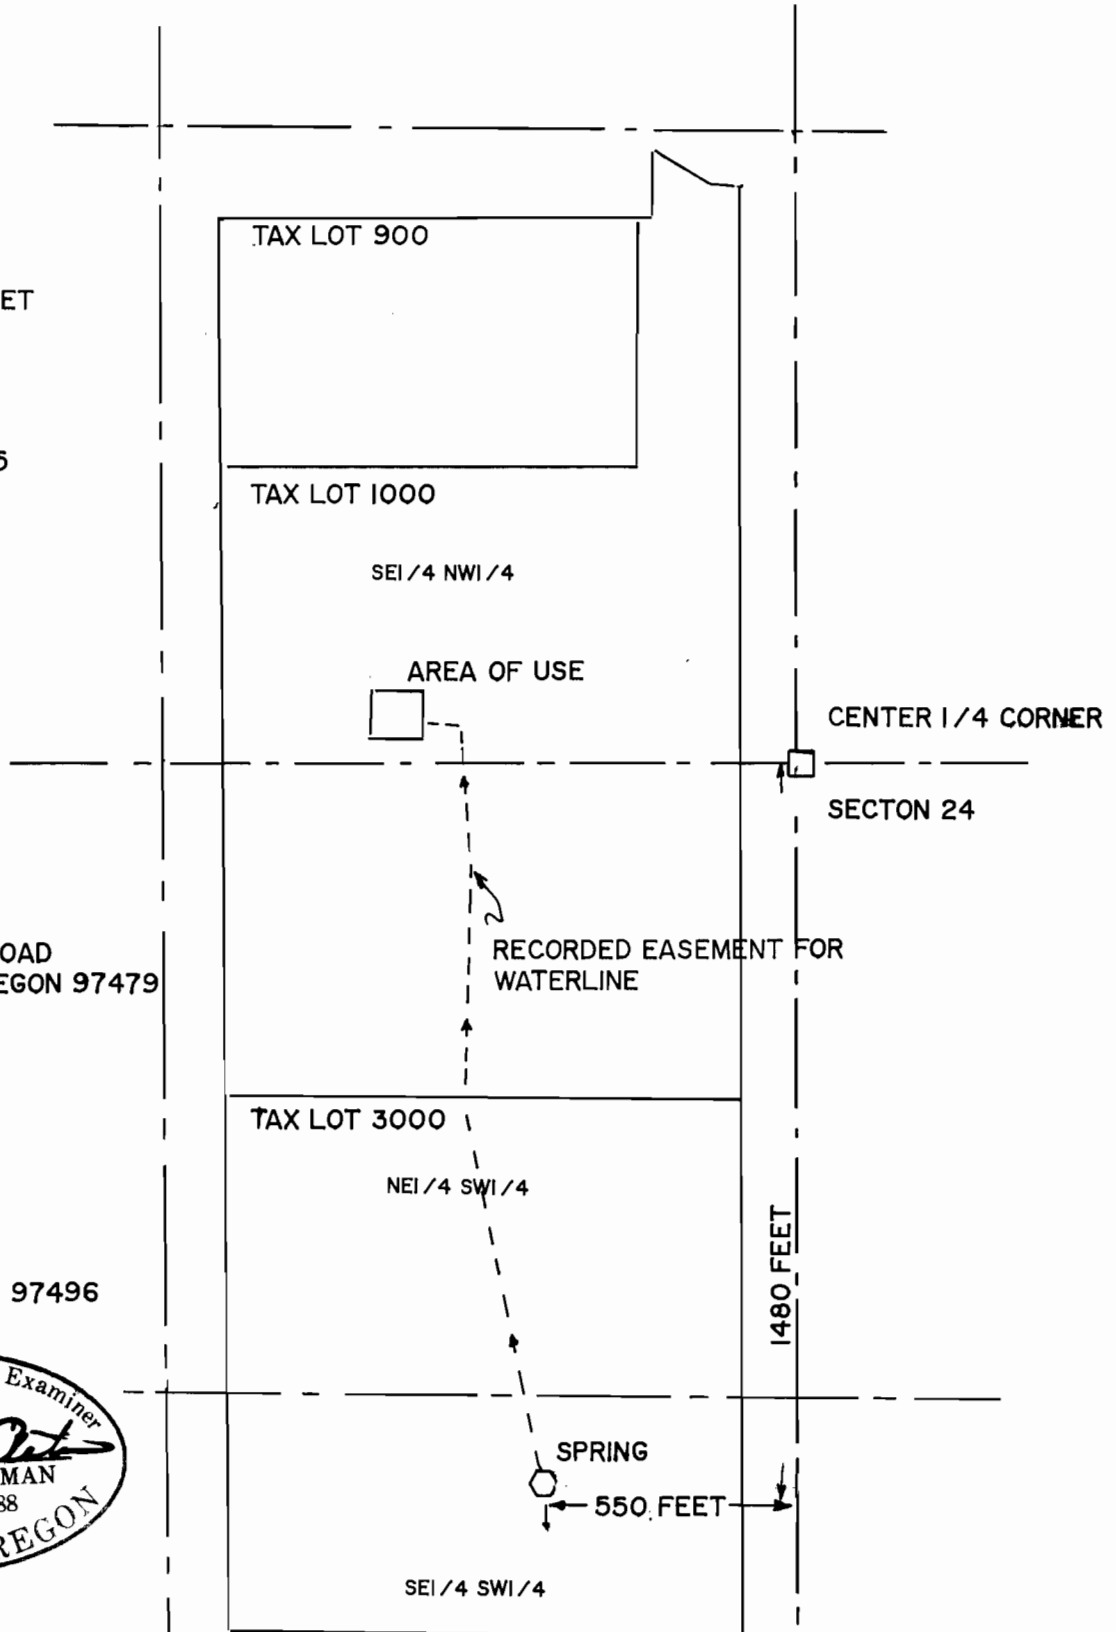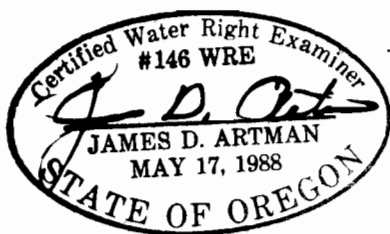

NOTE: THIS MAP TO ACCOMPANY SITE REPORT