

TOWNSHIP 26 SOUTH, RANGE 4 WEST, W.M.

SECTION 13

NW SEC. COR.

SCALE:
1 INCH = 1320 FEET



DIVERSION POINT IS LOCATED 2770' S. & 1050' E. FROM NW SEC. COR.

FINAL PROOF SURVEY

for


MARLIN LARSEN

APPLICATION 70070 PERMIT 50800

RECEIVED

NOV 15 2001

WATER RESOURCES DEPT.
SALEM, OREGON

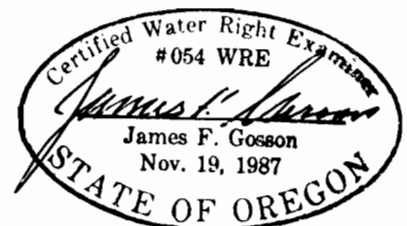

THE PURPOSE OF THIS MAP IS TO IDENTIFY THE LOCATION OF THE WATER RIGHT. IT IS NOT INTENDED TO PROVIDE INFORMATION RELATIVE TO THE LOCATION OF PROPERTY OWNERSHIP BOUNDARY LINES.