


T22S, R7W, WM

DOUGLAS COUNTY

SCALE 1" = 1320'

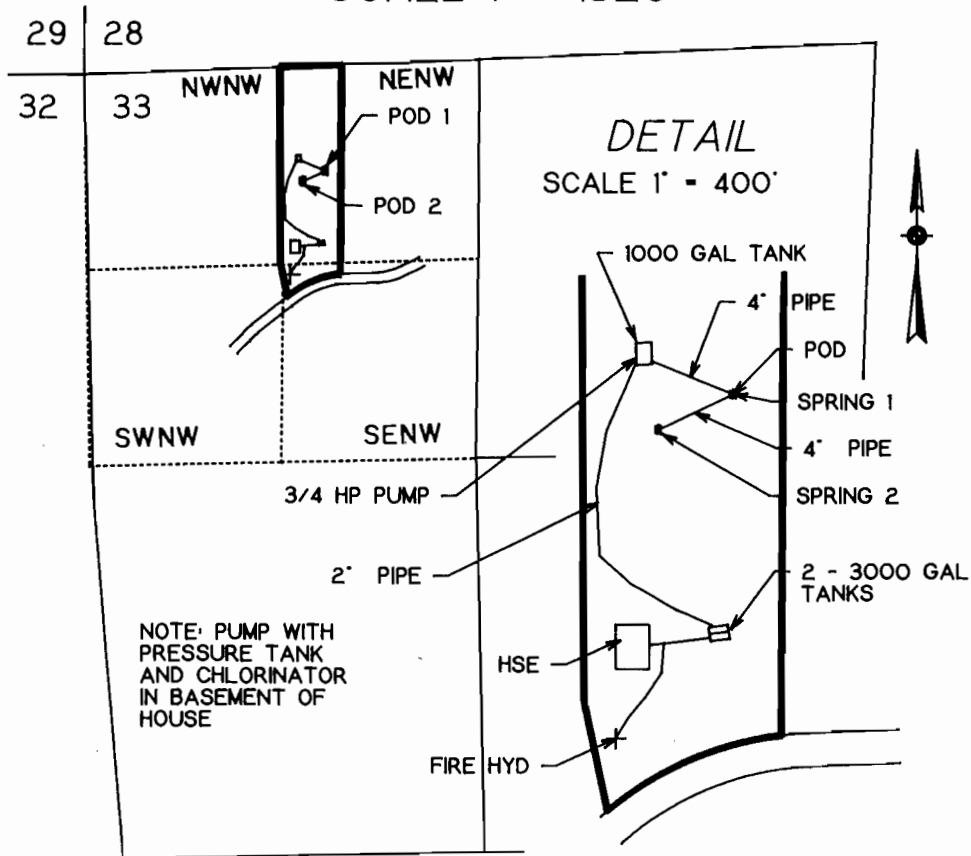

POD 1 IS 650 FT S AND 1670 FT E FROM NW COR SEC 33
POD 2 IS 720 FT S AND 1510 FT E FROM NW COR SEC 33

FINAL PROOF SURVEY

UNDER


Application No. 70157 Permit No. 51083

IN NAME OF

PAUL R. OR ALICE FAYE ELLIS

Surveyed Sept 14, 1994 by M.E. Farr

THIS IS A LOCATION MAP FOR A FINAL PROOF SURVEY BY PAUL R. OR ALICE FAYE ELLIS. THIS MAP IS FOR THE PURPOSE OF IDENTIFYING THE LOCATION OF THE WATER RIGHT ONLY AND IS NOT INTENDED TO PROVIDE LEGAL DIMENSIONS OR LOCATIONS OF PROPERTY OWNERSHIP LINES.

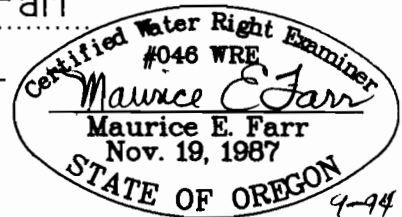

EXPIRES 12-31-95