


FINAL PROOF SURVEY MAP

IN THE NAME OF E. ALLEN AND LORRAINE WALKER
SECTION 2, TOWNSHIP 26 SOUTH, RANGE 3 WEST, W.M.

APPLICATION 70290

PERMIT 51106

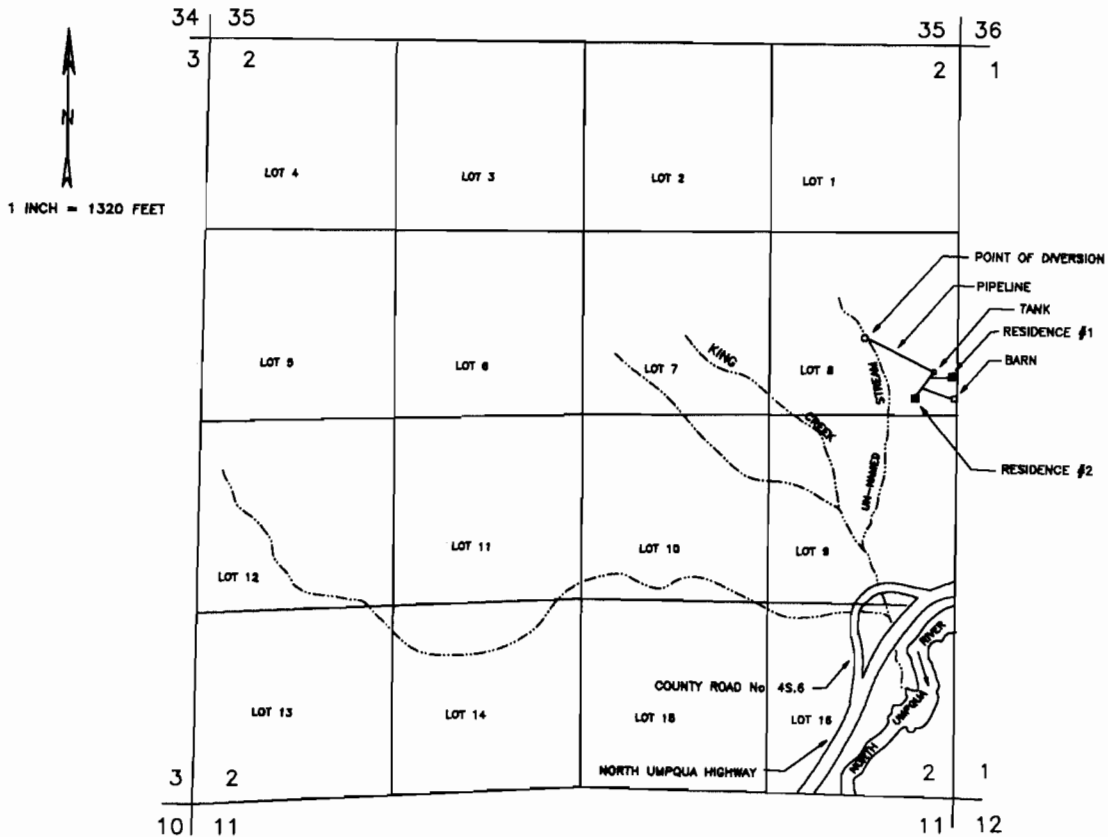

THE POINT OF DIVERSION IS LOCATED 2000 FEET SOUTH AND 640 FEET WEST FROM THE NORTHEAST CORNER OF SECTION 2, BEING WITHIN THE SOUTHEAST 1/4 OF THE NORTHEAST 1/4 OF SECTION 2, TOWNSHIP 26 SOUTH, RANGE 3 WEST, W.M., DOUGLAS COUNTY.

THE PURPOSE OF THIS MAP IS TO IDENTIFY THE LOCATION OF THE WATER RIGHT. IT IS NOT INTENDED TO PROVIDE INFORMATION RELATIVE TO THE LOCATION OF PROPERTY OWNERSHIP BOUNDARY LINES.

